


T.4S.R.IE.W.M.

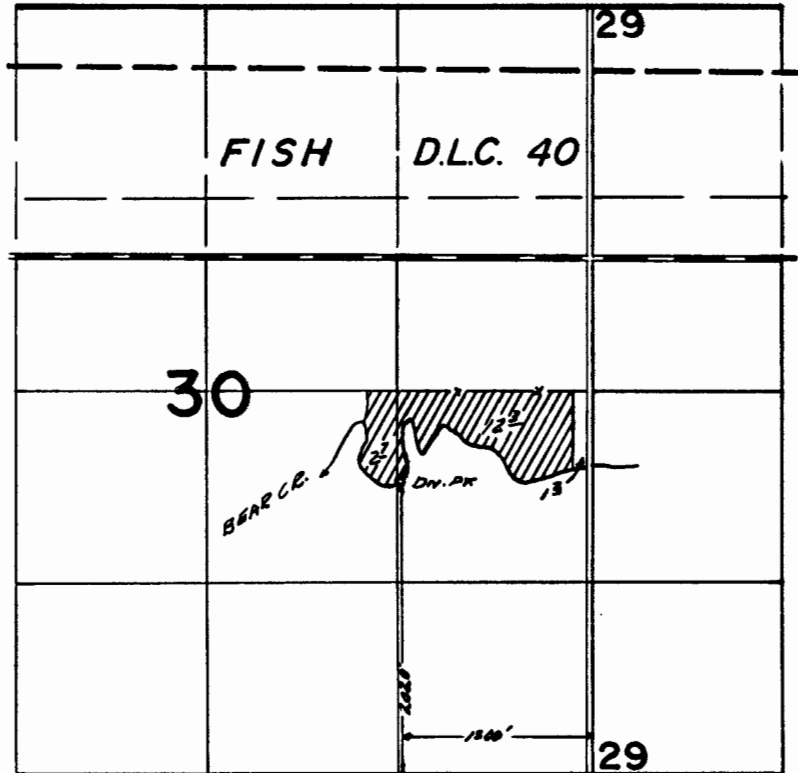

FINAL PROOF SURVEY UNDER

TRANSFER No. 3302
Application No. Permit No.
IN NAME OF

...ROBERT W. & THERESA A. MAY...

Surveyed ...MAY... 4, 1978, by J.S. Donaldson..