


T. 5S. R. 2E.W.M.

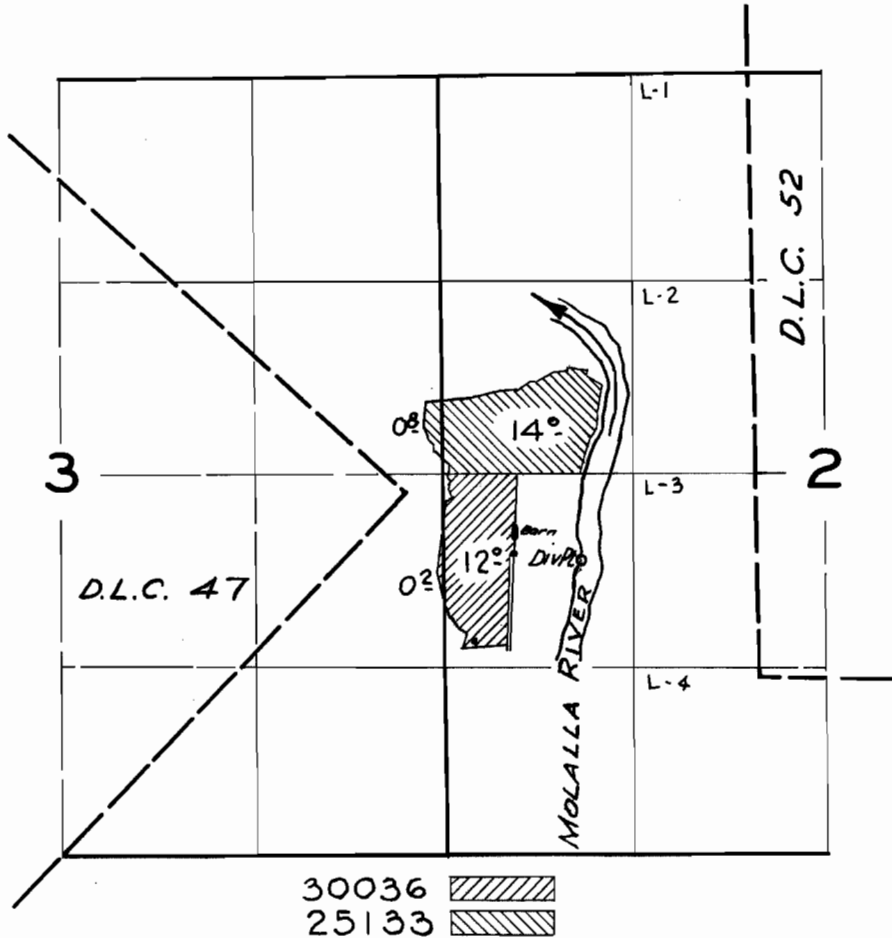

FINAL PROOF SURVEY
UNDER

30036 23645
Application No. 25133. Permit No. 19775
IN NAME OF

GERALD WHITAKER

Surveyed 17 June 1958, by C.O. Bartels