


T.29S. R.14W. W.M.

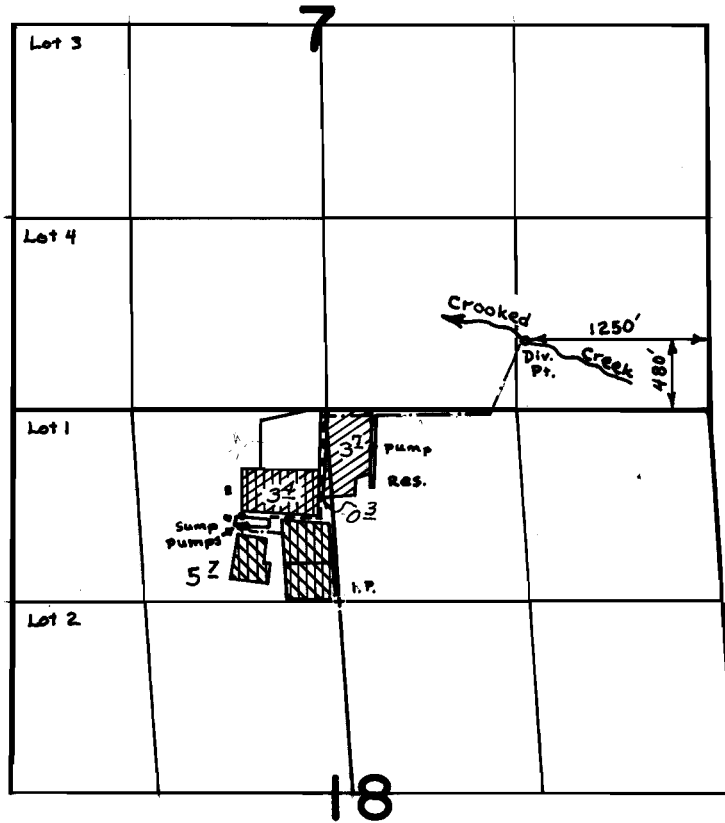

SCALE: 4" = 1 mile

**FINAL PROOF SURVEY**  
UNDER

G-5399                      G-5324  
47858                      35867  
Application No. 47859    Permit No. 35868

▨▨▨▨▨▨▨▨▨▨
▨▨▨▨▨▨▨▨▨▨
▨▨▨▨▨▨▨▨▨▨

IN NAME OF

**FRANK H. & VIOLA M. GOULD**

Surveyed June 14, 1979, by S. Donaldson.  
Oct. 30, 1975                      L. E. Gould

AKS  
200