



T.29S. R.14W. W.M.

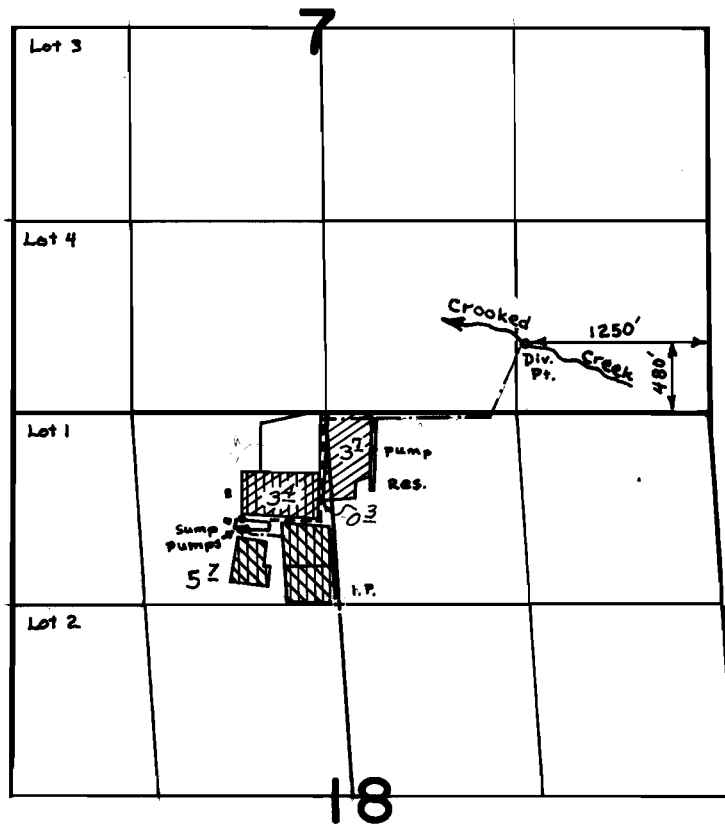

SCALE: 4" = 1 mile

FINAL PROOF SURVEY
UNDER

G-5399 G-5324
47858 35867
Application No. 47859 Permit No. 35868

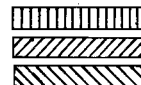

IN NAME OF

FRANK H. & VIOLA M. GOULD

Surveyed June 14, 1979, by S. Donaldson.
Oct. 30, 1975 L. E. Gould

200