


T. 26 S., R. 3 W., W.M.

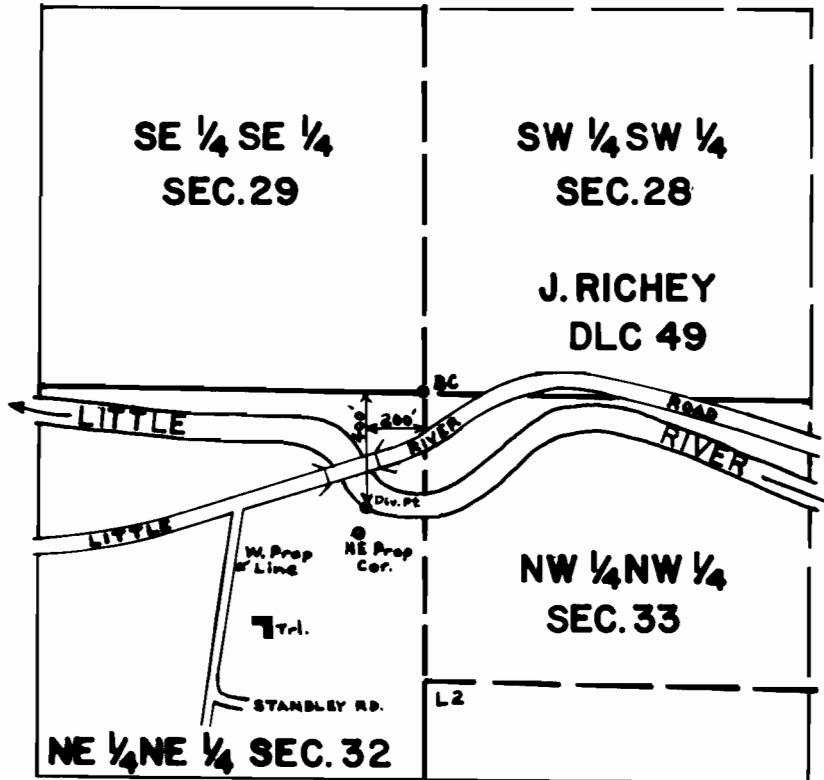

Scale: 1" = 660'

**FINAL PROOF SURVEY**  
UNDER

Application No. 54690... Permit No. 41033.....  
IN NAME OF

**HENRY & CAROLINE BROCKELMEYER**

Surveyed OCT. 24... 1977, by D.W. SPARKS.....