


T.29S. R.4W. W.M.

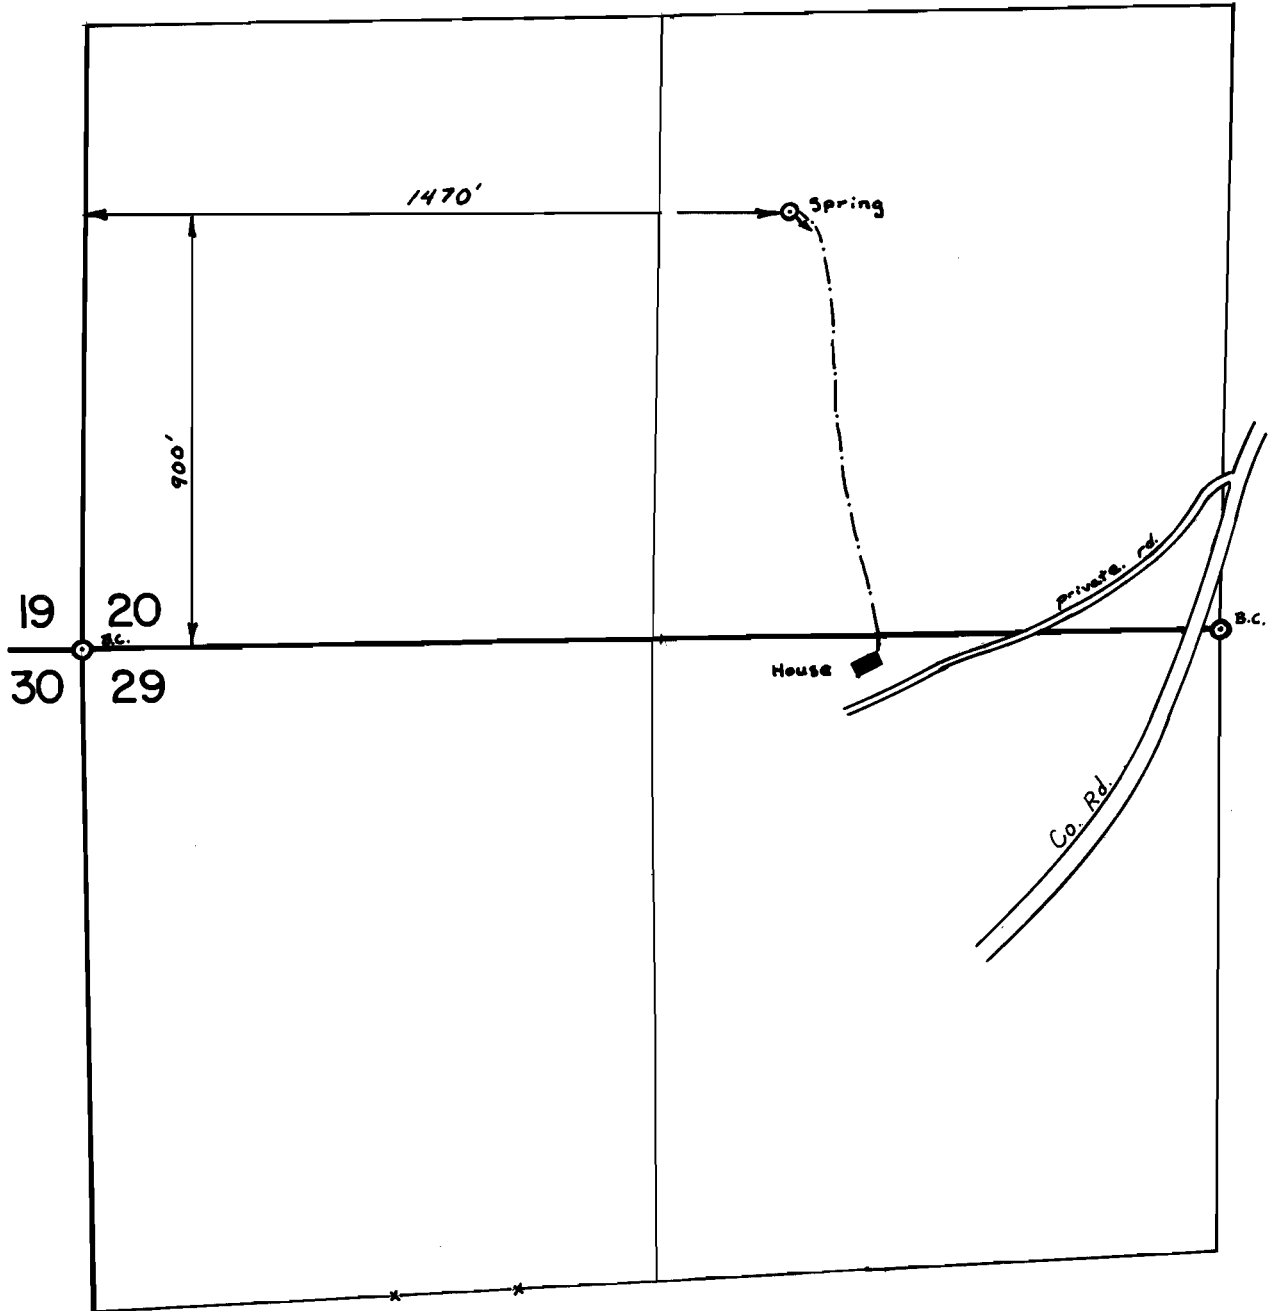

FINAL PROOF SURVEY
UNDER

SCALE: 1" = 400'

Application No. 51838 Permit No. 39033
IN NAME OF

RENALD A. MONTPAS

Surveyed Nov. 7, 1978, by S. Donaldson