


T. 32 S., R. 5 W., W.M.

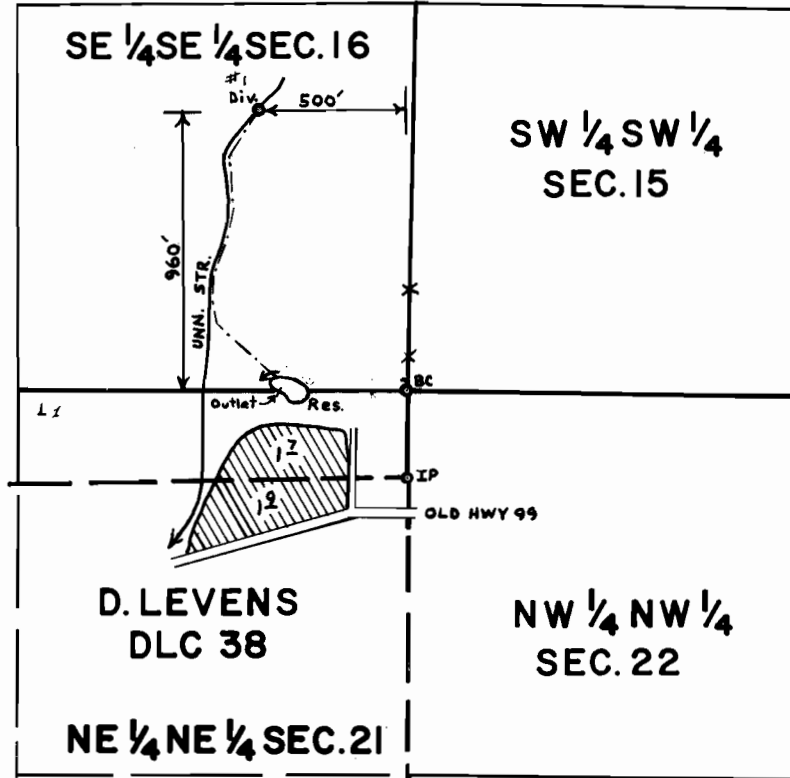

SCALE: 1" = 660'

FINAL PROOF SURVEY
UNDER

R-49343 R-5994
Application No. 49244 Permit No. 36907
IN NAME OF

HAROLD L. SHEPPARD

Surveyed JAN. 17, 1978, by D.W. SPARKS...