


T. 32 S., R. 5 W., W.M.

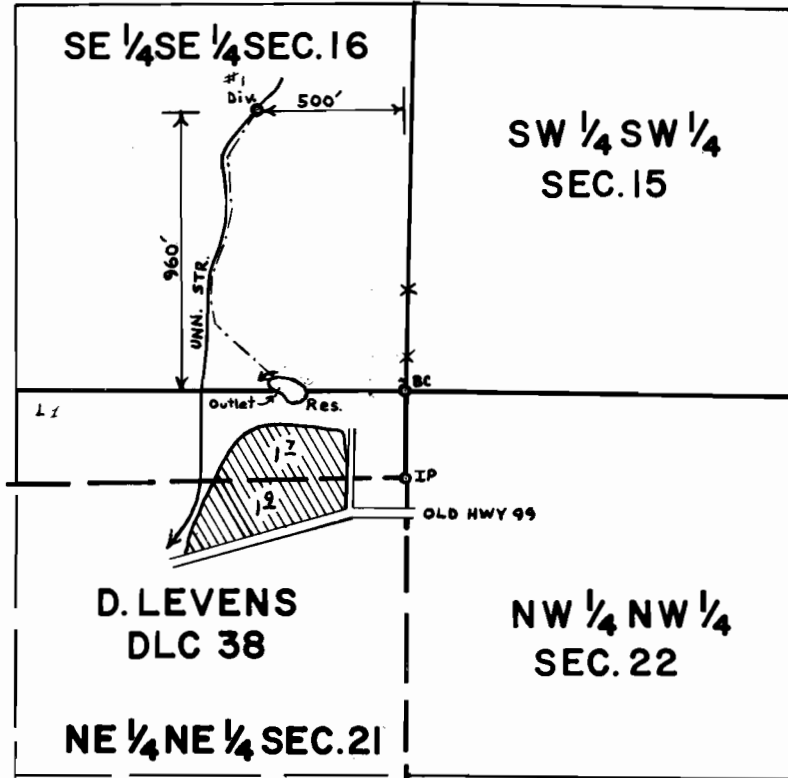

SCALE: 1" = 660'

**FINAL PROOF SURVEY**  
UNDER

R-49343                      R-5994  
Application No. 49244      Permit No. 36907  
IN NAME OF

**HAROLD L. SHEPPARD**

Surveyed JAN. 17, 1978, by D.W. SPARKS...