


T. 30S. R. 5W. W.M.

Sec. 21

SE 1/4 SE 1/4

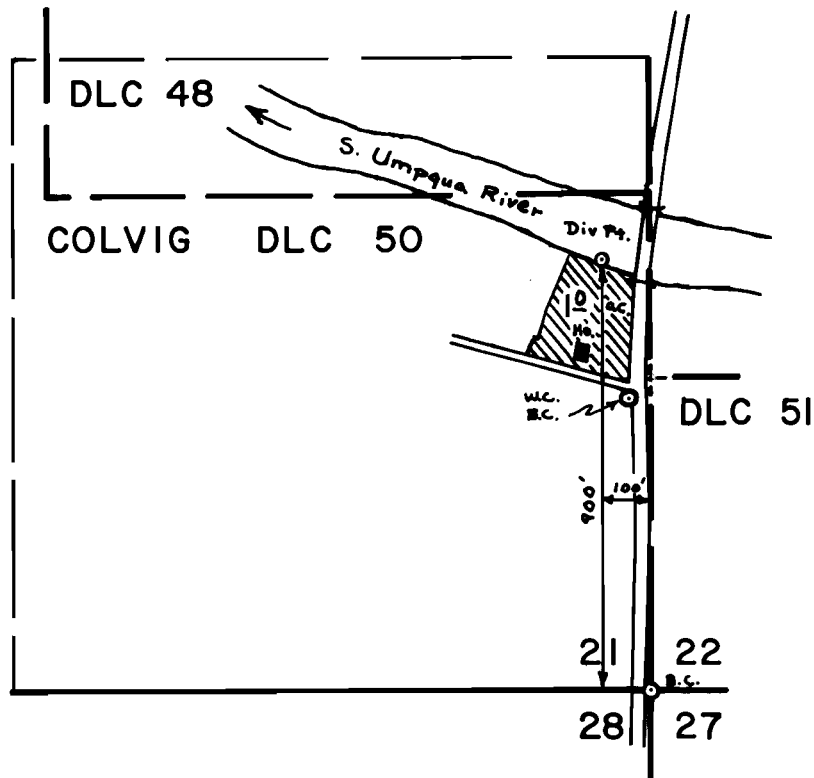

SCALE: 1" = 400'

FINAL PROOF SURVEY
UNDER

Application No. 53910 Permit No. 40223
IN NAME OF

LAWRENCE J. BOYLE

Surveyed Feb. 3, 1978, by D. Sparks