


T.25S. R.6W. W.M.

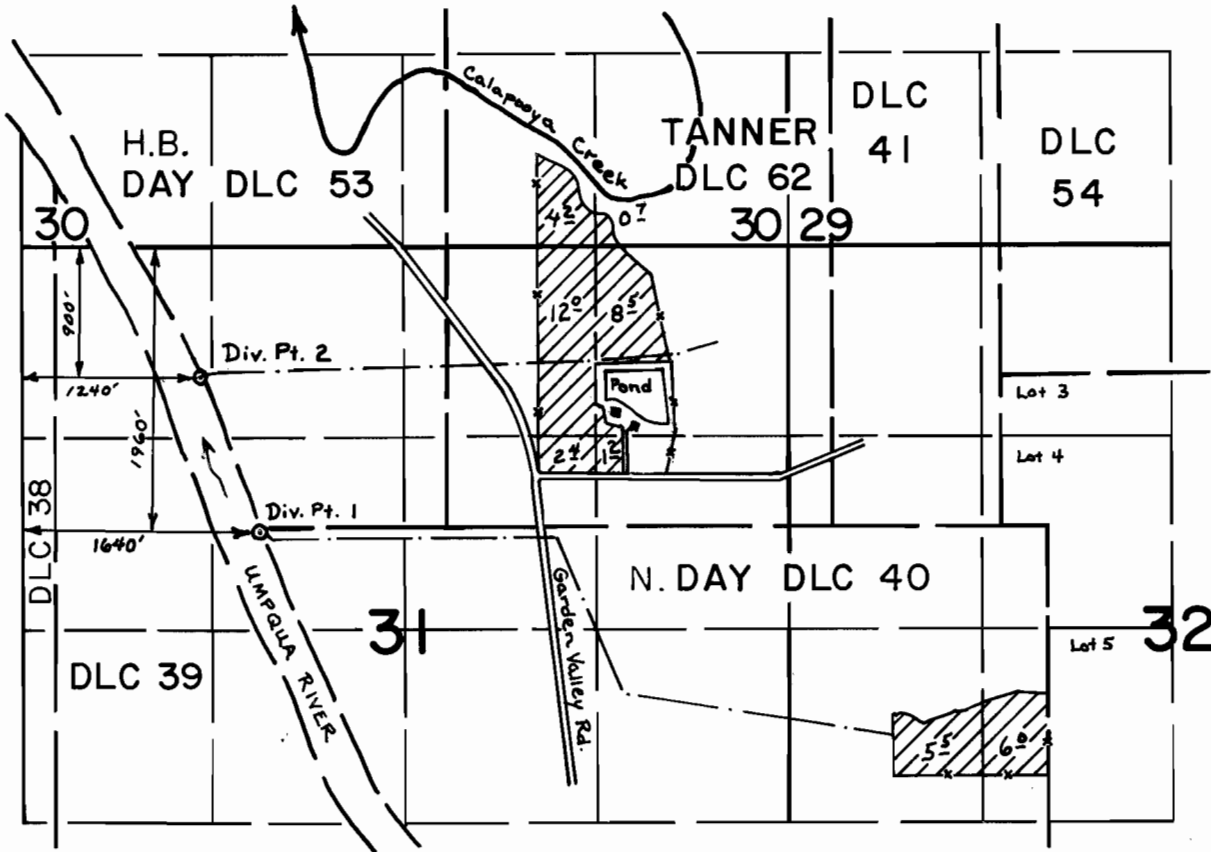

**FINAL PROOF SURVEY**  
UNDER

Application No. 49193 Permit No. 36877

IN NAME OF  
SANDY & PAUL NORRIS  
McCLELLAN O. & DOROTHY B. KNAPP

Surveyed July 17 & 19 1979, by S. Donaldson.