


T. 27S., R. 7W., W.M.

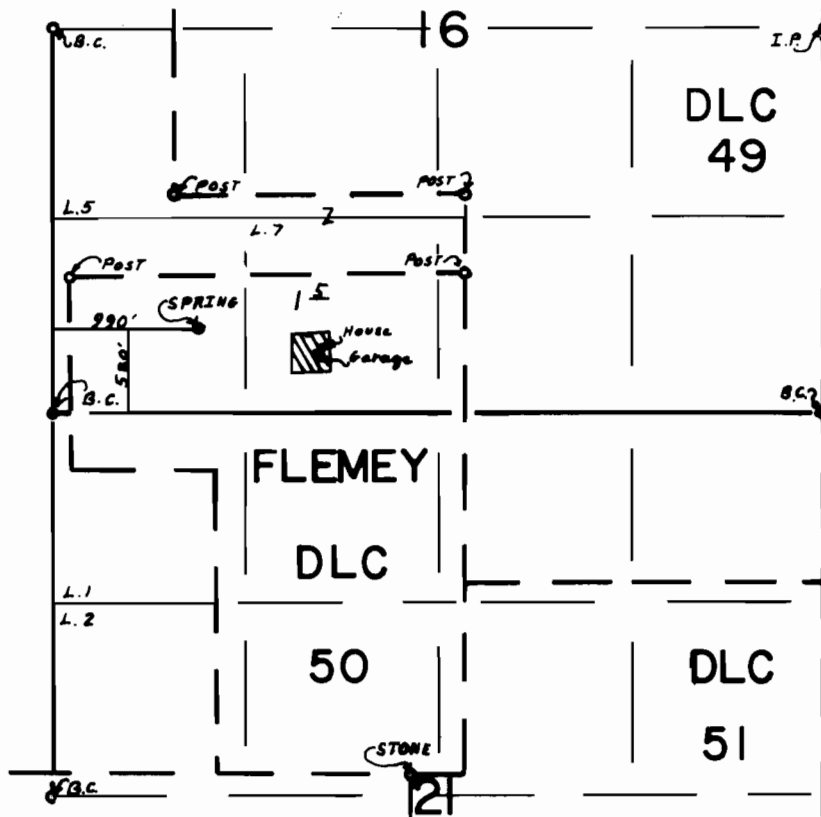

FINAL PROOF SURVEY UNDER

Application No. 54698 Permit No. 41037
IN NAME OF

CASEY J. & JOYCE MORGAN

Surveyed OCT. 19 1977, by D.W. SPARKS