


T.27S., R.6W., W.M.

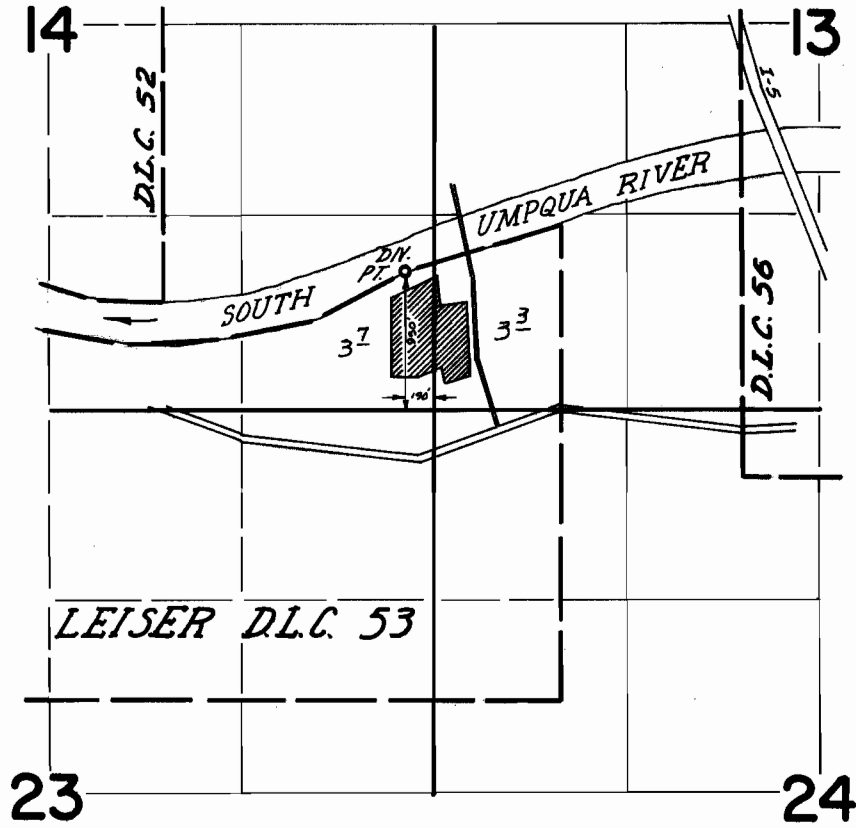

FINAL PROOF SURVEY
UNDER

Application No. 48034 Permit No. 36020
IN NAME OF

CITY OF ROSEBURG

Surveyed Sept 11 1974, by D. NORBY