


P-36672
C-49675

T9S. R27E. WM.

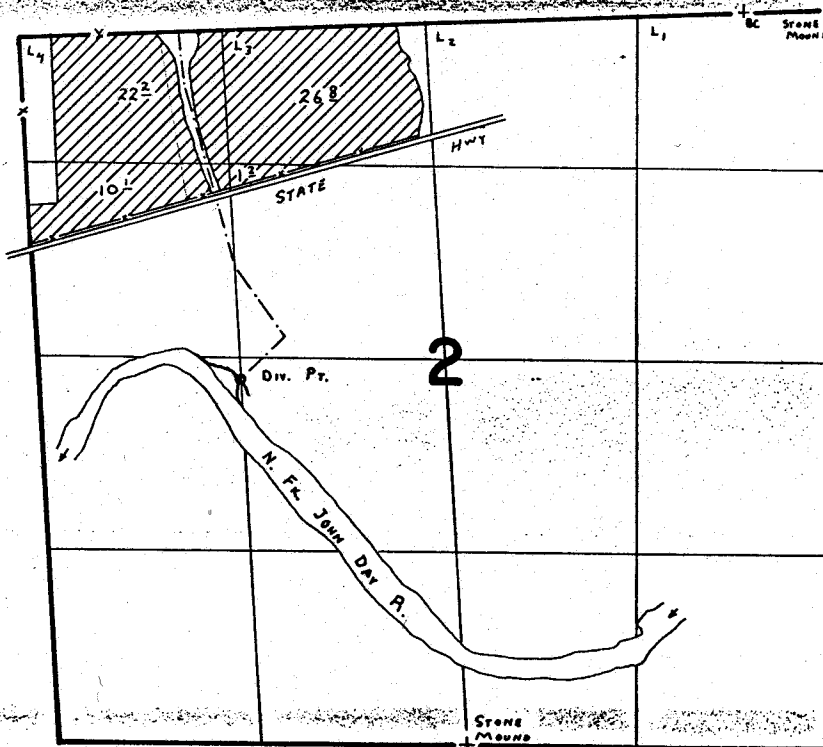

Div. Pt. Loc: 2320'S. & 1550' E. fr. N.W. Cor. SEC. 2.

FINAL PROOF SURVEY UNDER

Application No. 48982 Permit No. 36672.....
IN NAME OF

.....LEONARD CARLSON.....

Surveyed Oct. 17 1977, by S. C. BROWN.....