


Per # 47

49680

1399


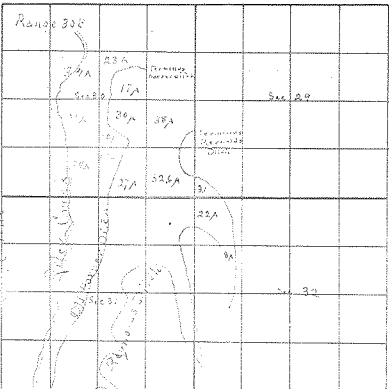


Map of Reynolds Ditch  
G.W. Reynolds

ALSO SEE MAP  
G.W. Reynolds

7


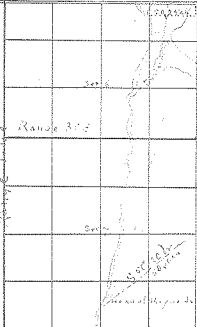


Application No. 677.

Enlargement Permit No. 47.

Gov Reserve