


T. 36S. R. 5W. W.M.

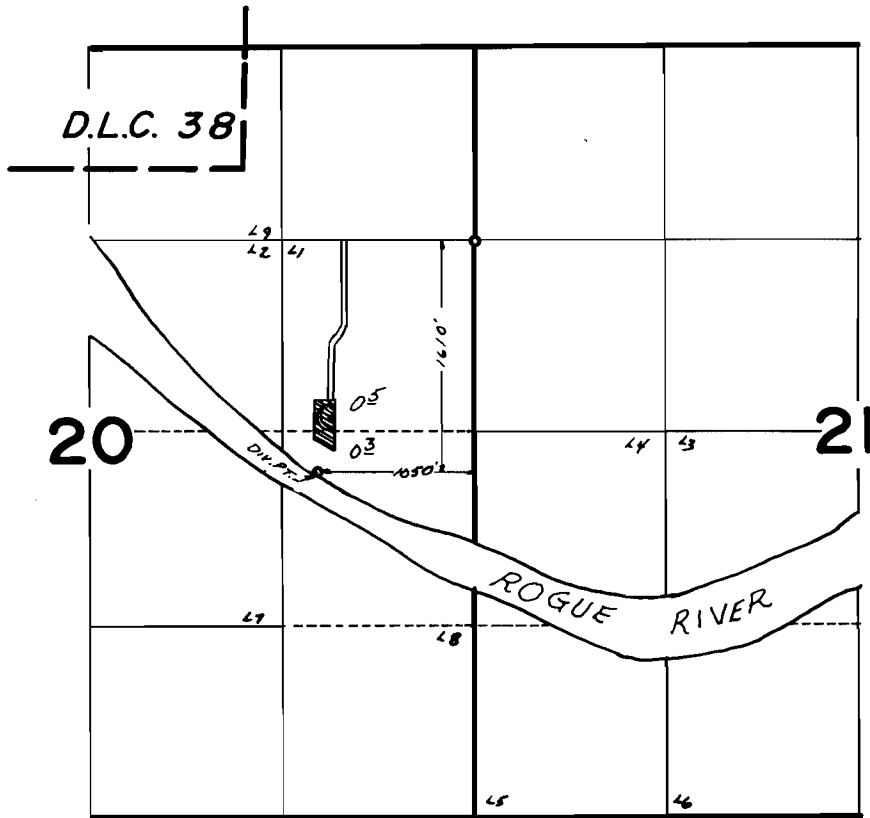

FINAL PROOF SURVEY
UNDER

Application No. 37971..... Permit No. 28429.....
IN NAME OF

.....DONALD R. SMITH.....

Surveyed June 21, 1965, by R.H.JACKSON.....