


31520

44736
49710
T4422
64814
81238

T39S. R.20E. W.M.

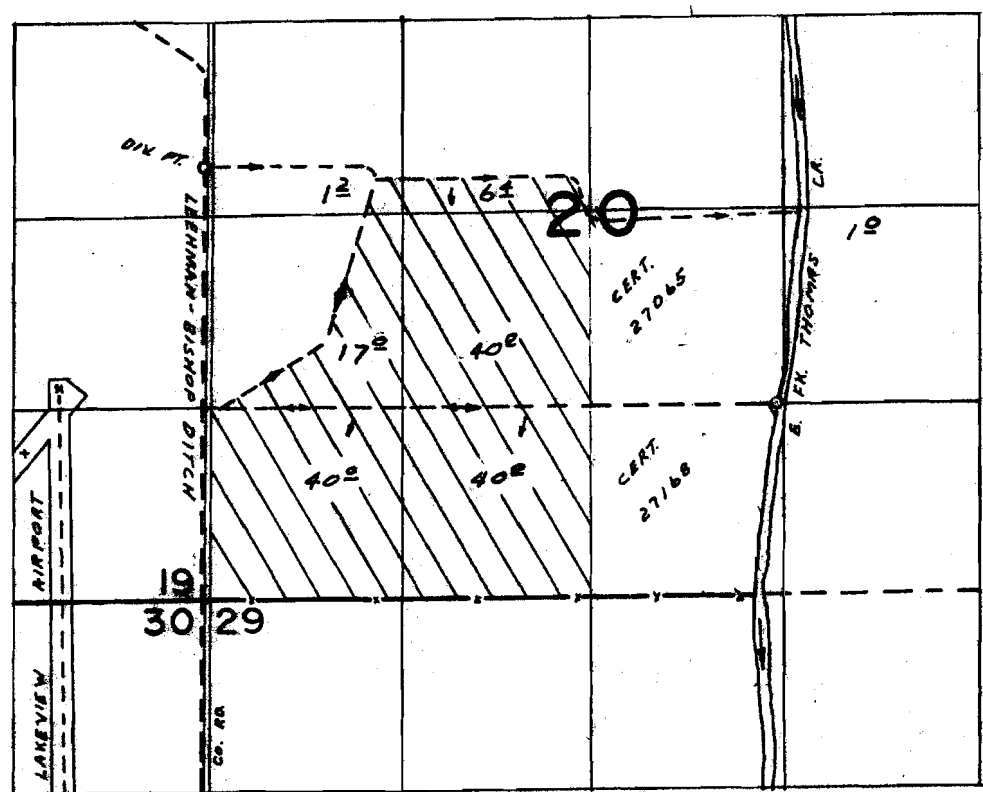

DITCH DIV. PT. LOC. 330' N & 40' W FROM W. 1/4 COR. SEC. 20
CREEK DIV. PT. LOC. 1300' N & 1200' E FROM S. 1/4 COR. SEC. 20

See Map 44976
T4422

FINAL PROOF SURVEY UNDER

Application No. 42043 Permit No. 31520
IN NAME OF

J. BOYD TAYLOR

Surveyed JUL. 9. 1975, by L.H. NUNN

NOTED
TAYLOR