


# T.17 S.R.10 W. W.M.

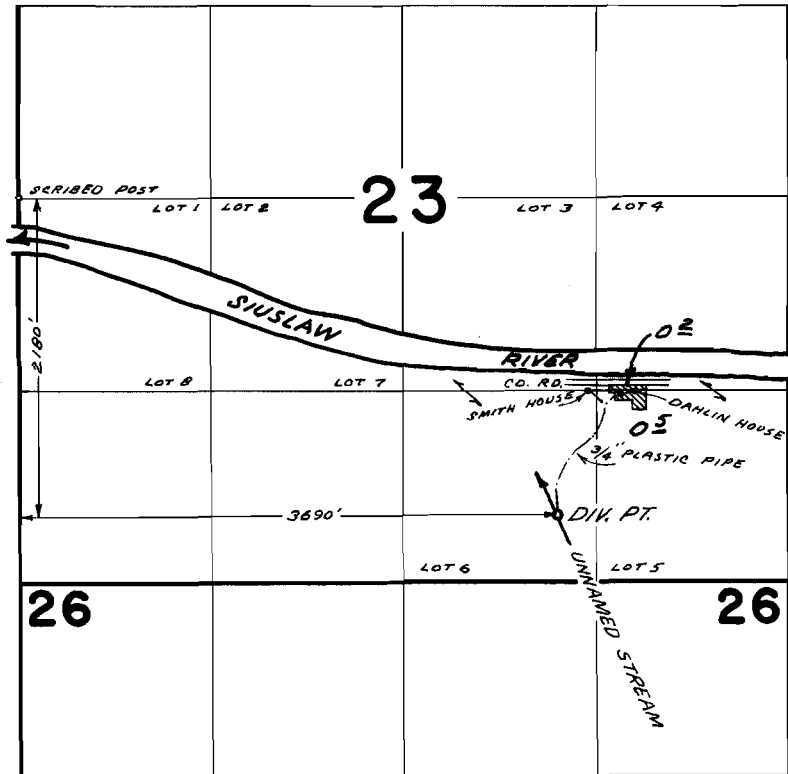

## FINAL PROOF SURVEY UNDER

Application No. 39885 Permit No. 29694

IN NAME OF  
**LAWRENCE E. DAHLIN AND  
KENNETH C. SMITH**

Surveyed AUG 7 1969, by D. BUELL