


T.8S. R.28 & 3W.W.M.

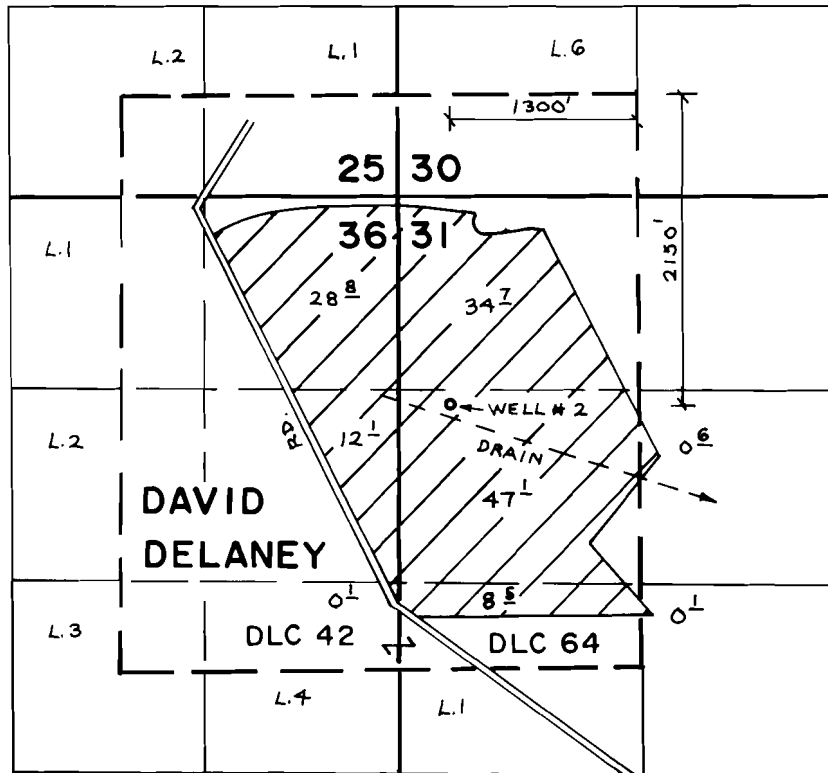

FINAL PROOF SURVEY UNDER

G-5354 G-5293
 Application No. Permit No.

IN NAME OF

EDGAR S. FORTNER, JR., LUCILLE L. & BENJAMIN H. FORTNER

Surveyed Aug. 6, 1976, by R.G. Mucken