


# T. 5S. R. 1W. W.M.

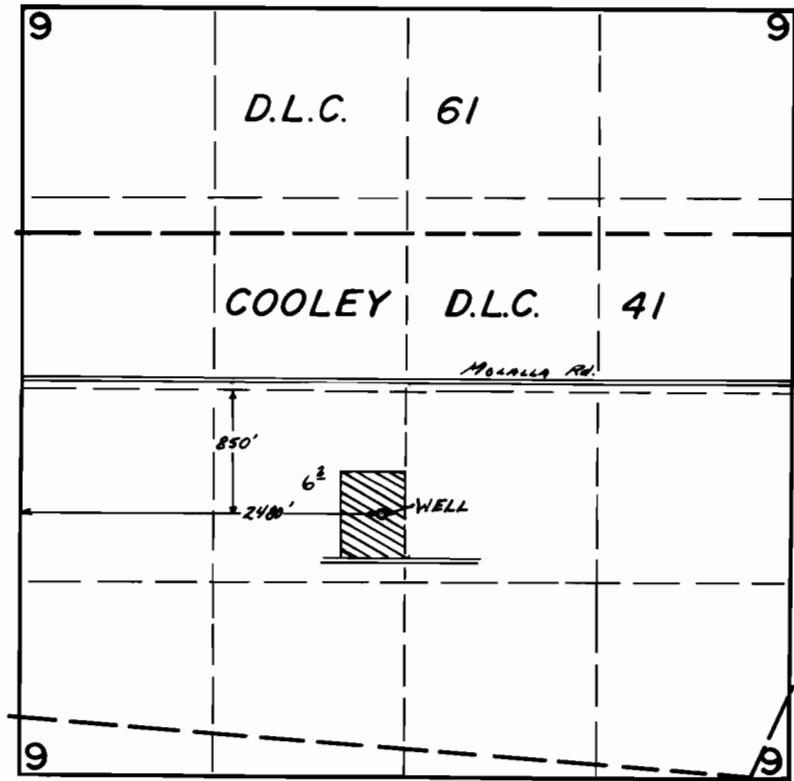

## FINAL PROOF SURVEY UNDER

Application No. G-7252 Permit No. G-7249  
IN NAME OF

.....SYLVESTER & MAY GAYKEN.....

Surveyed Aug. 15, 1978, by J.S. Donaldson...