


T.6S. R.1E. W.M.

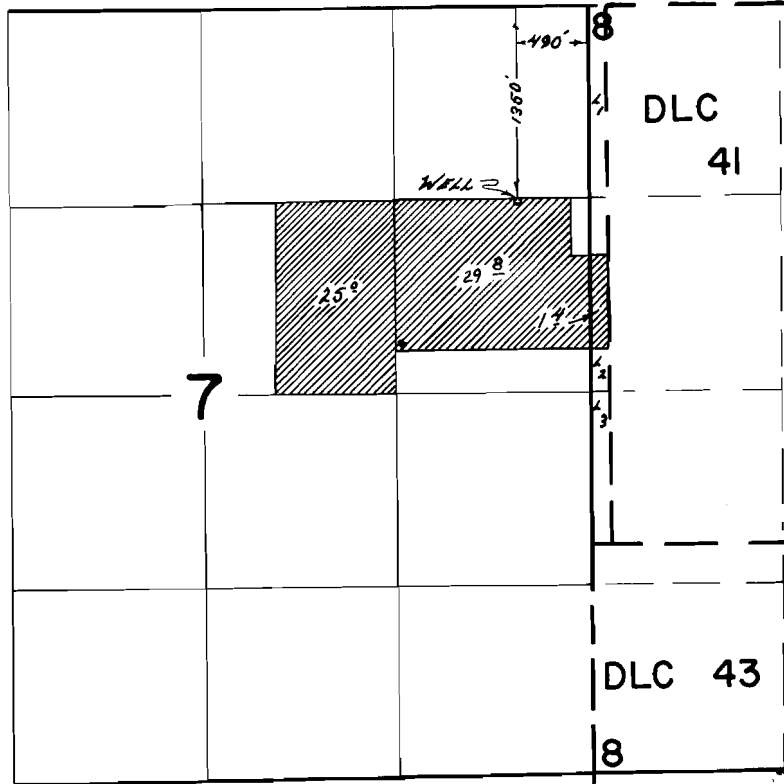

FINAL PROOF SURVEY
UNDER

Application No. G-4436 Permit No. G-4179
IN NAME OF

Samson Anfilofieff

Surveyed JUNE 7 1973, by R.B. MUCKEN