T.6S. R.1W., W.M.

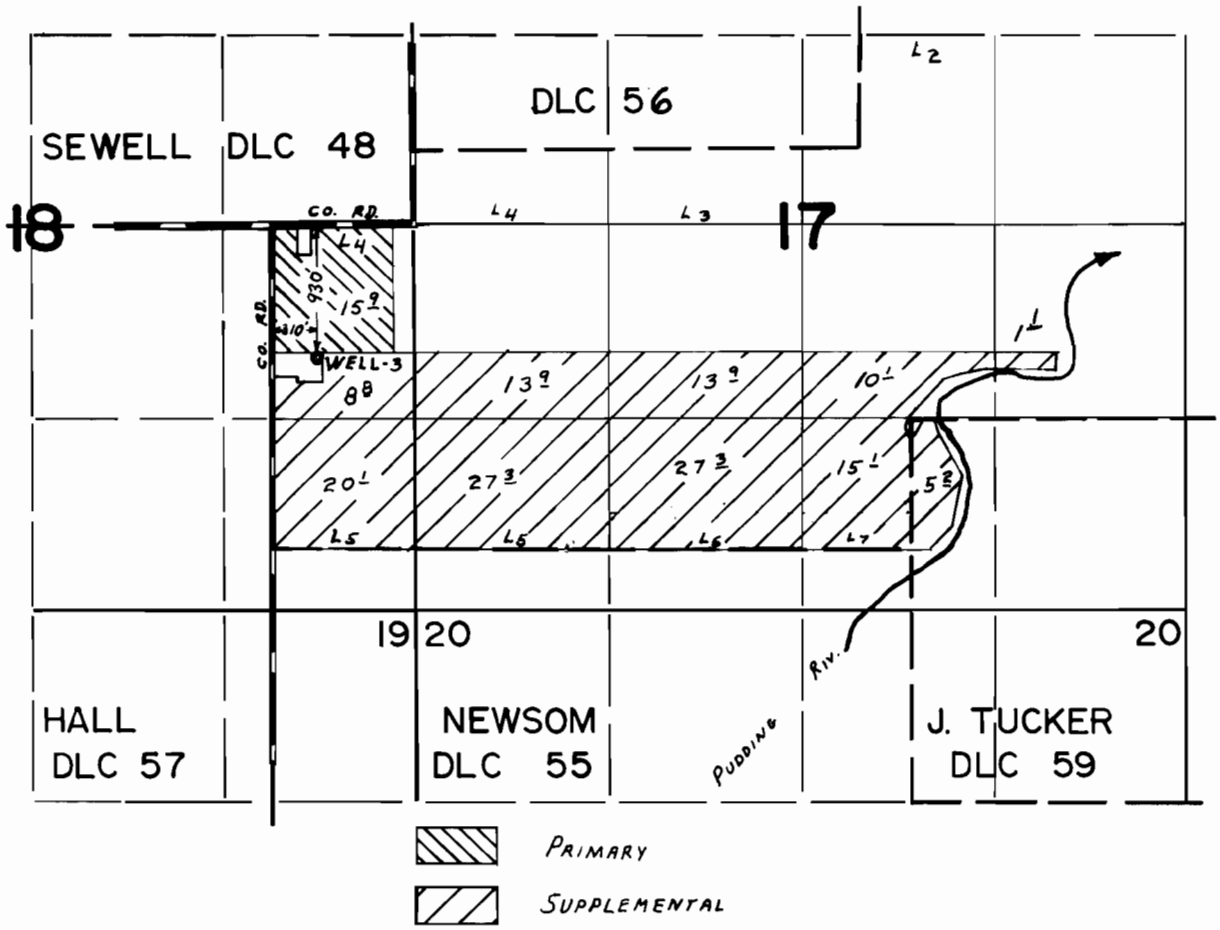

FINAL PROOF SURVEY
UNDER

Application No. G-7887 Permit No. G-7299
IN NAME OF

FRANK H. JOHNSON

Surveyed MAR 16 1978, by S.P. APPLEGATE

F.P. & DFN-1LL-40