


G-6879
49732

T. 4N. R. 28E. W.M.

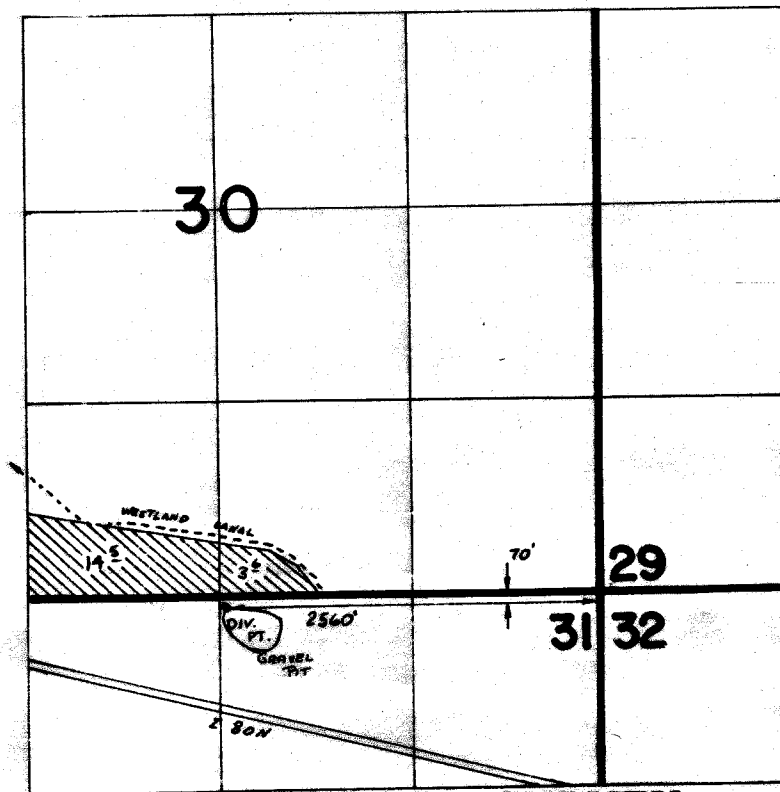

FINAL PROOF SURVEY
UNDER

Application No. G-5397 Permit No. G-6879
IN NAME OF

Walter Dean Buchanan

Surveyed 3-28 1978 by R. BARWIN

PT-1978-P-A
NE-35-8