
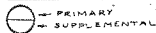


T.6N.R.35E.W.M.

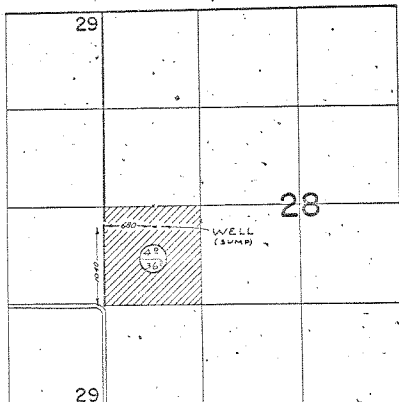

FINAL PROOF SURVEY UNDER

Application No. G-2692 Permit No. G-2204
IN NAME OF

SYBIL McK. BUCHWALTER & SYLVIA E. TURNER

Surveyed MAY 8 1971, by G. BAGA