


# MAP OF N H RUSSELL DITCH

Scale 10 Ch = 1 inch  
Total = 20.53 Acres

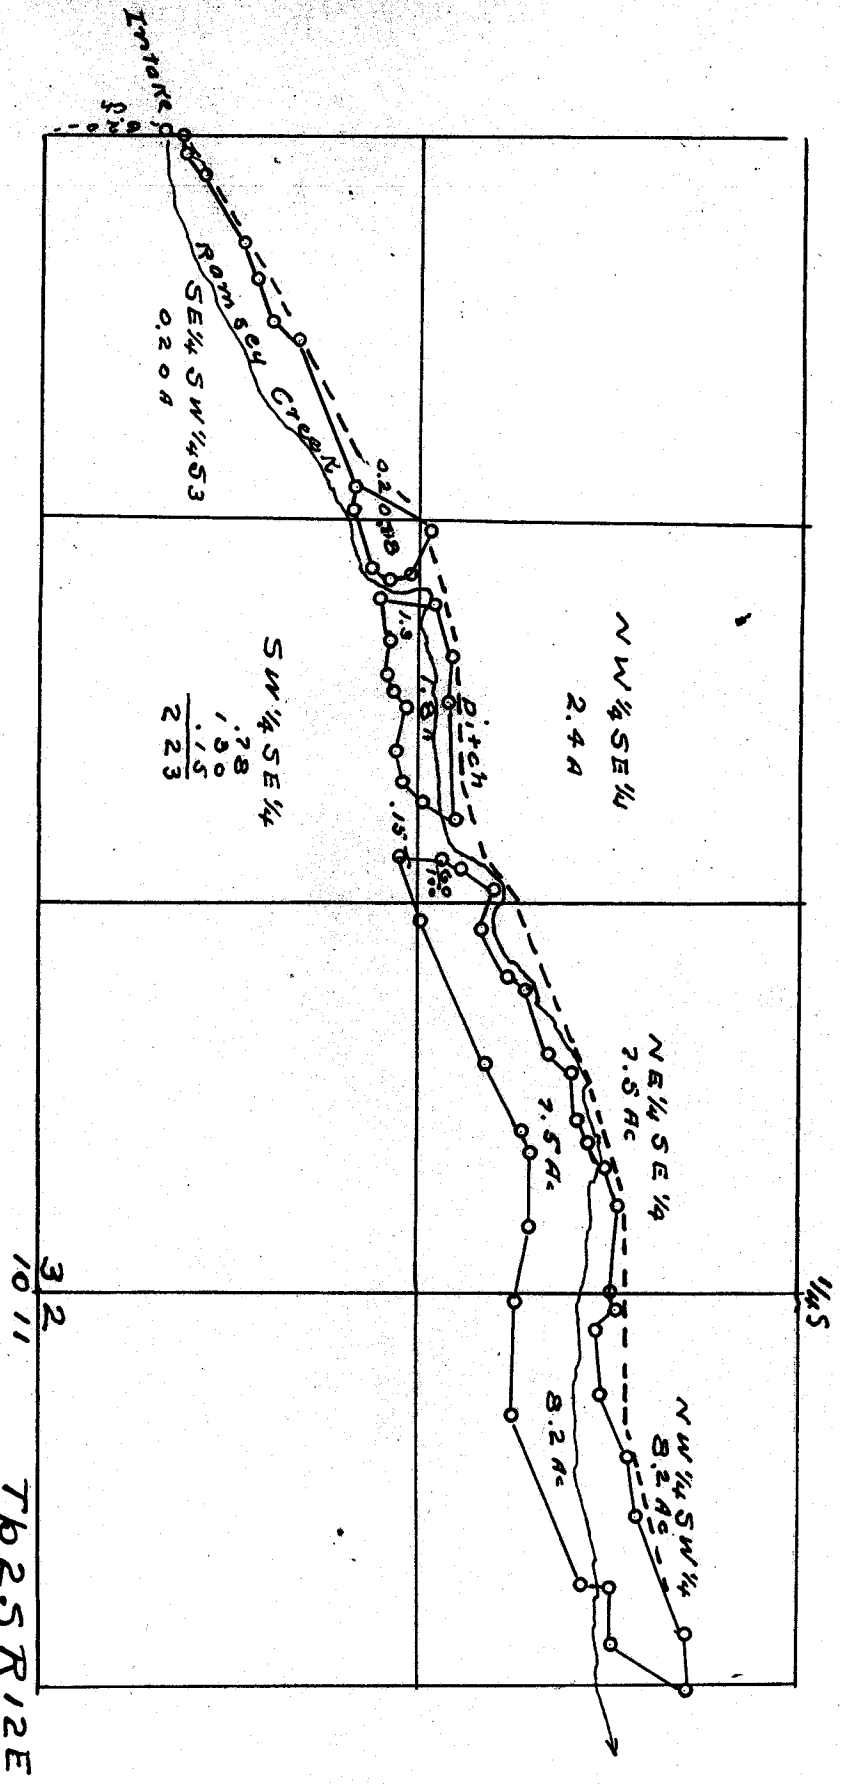

I AM MORE of the Dales Oregon do hereby certify this map was made from notes taken during an actual survey made by me on the 30th day of October 1919 and that it correctly represents the works described in the accompanying application together with the stream and other ditches in the immediate vicinity

A W Mohr  
County Surveyor

Certificate in adjudication issued to match map in proof of claimant not state engineer maps

LMT  
WMS