


T.2N. R.3W. W.M.

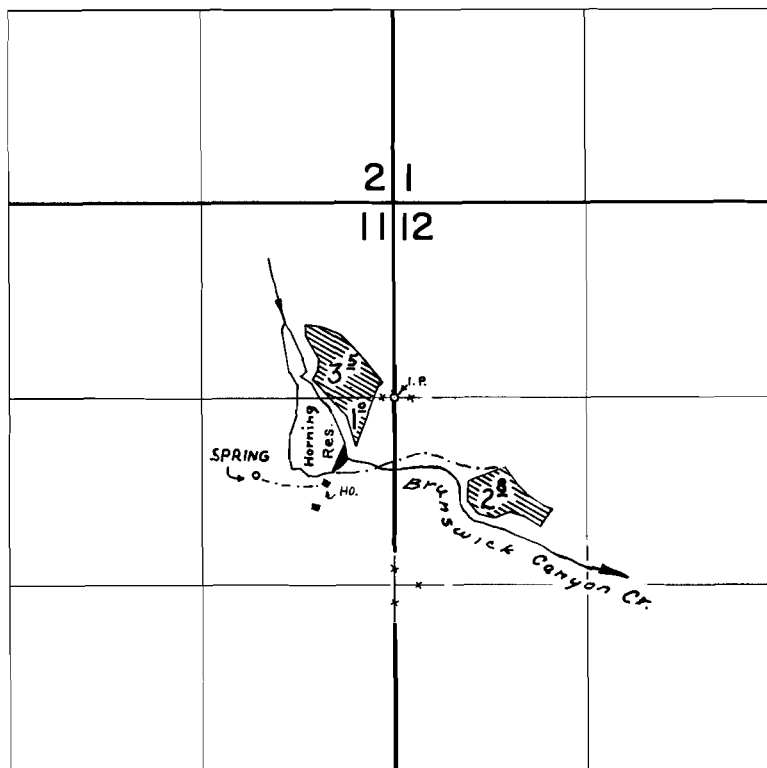

DAM LOC: 880' N. AND 380' W. FROM E. 1/4 COR. SEC. 11
SPRING LOC: 750' N. AND 950' W. FROM E. 1/4 COR. SEC. 11

FINAL PROOF SURVEY UNDER

48289 36264
R-48956 R-5757
Application No. 48957 Permit No. 35725
IN NAME OF

RICHARD L. HORNING

Surveyed May 21 76
Sept. 9, 1975, by R. Mucken