


T.3S.R.3W.W.M.

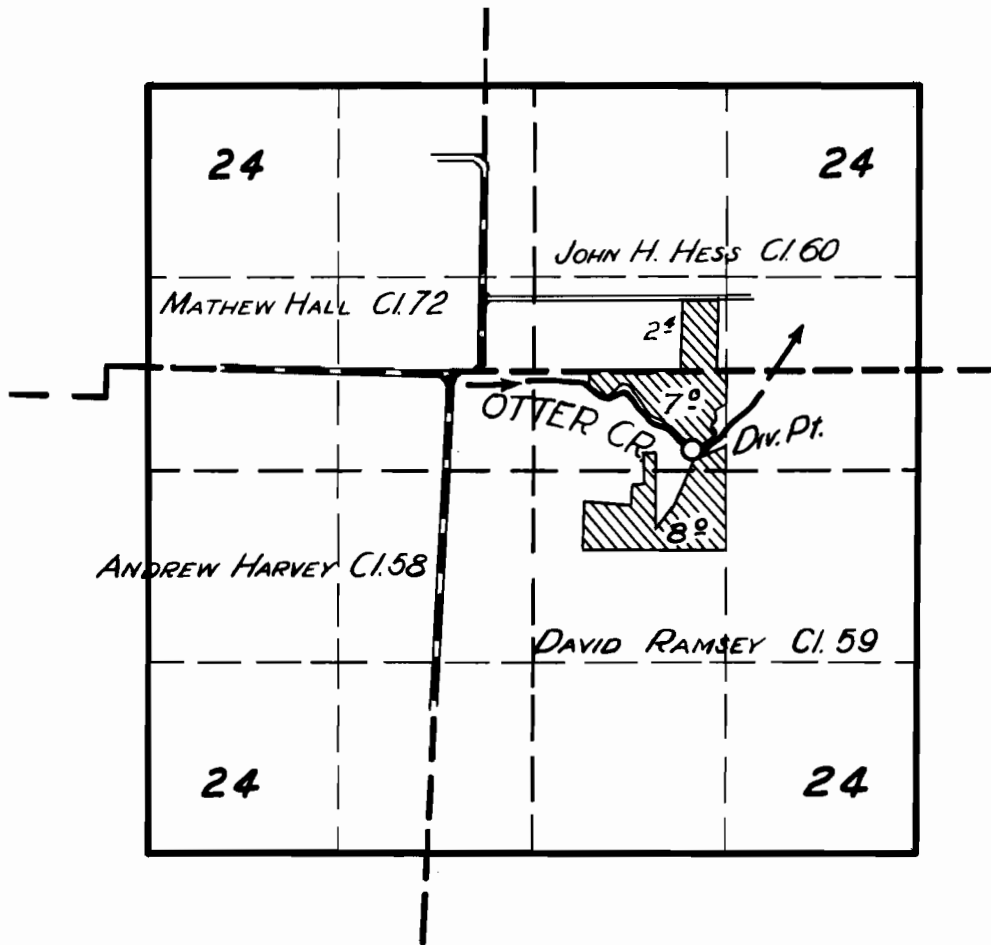

FINAL PROOF SURVEY

UNDER

Application No. 24070 Permit No. 19198

IN NAME OF

Douglas R. Dickie & Clare Dickie

Surveyed 14 Oct. 1955, by *C. P. Whitby*