


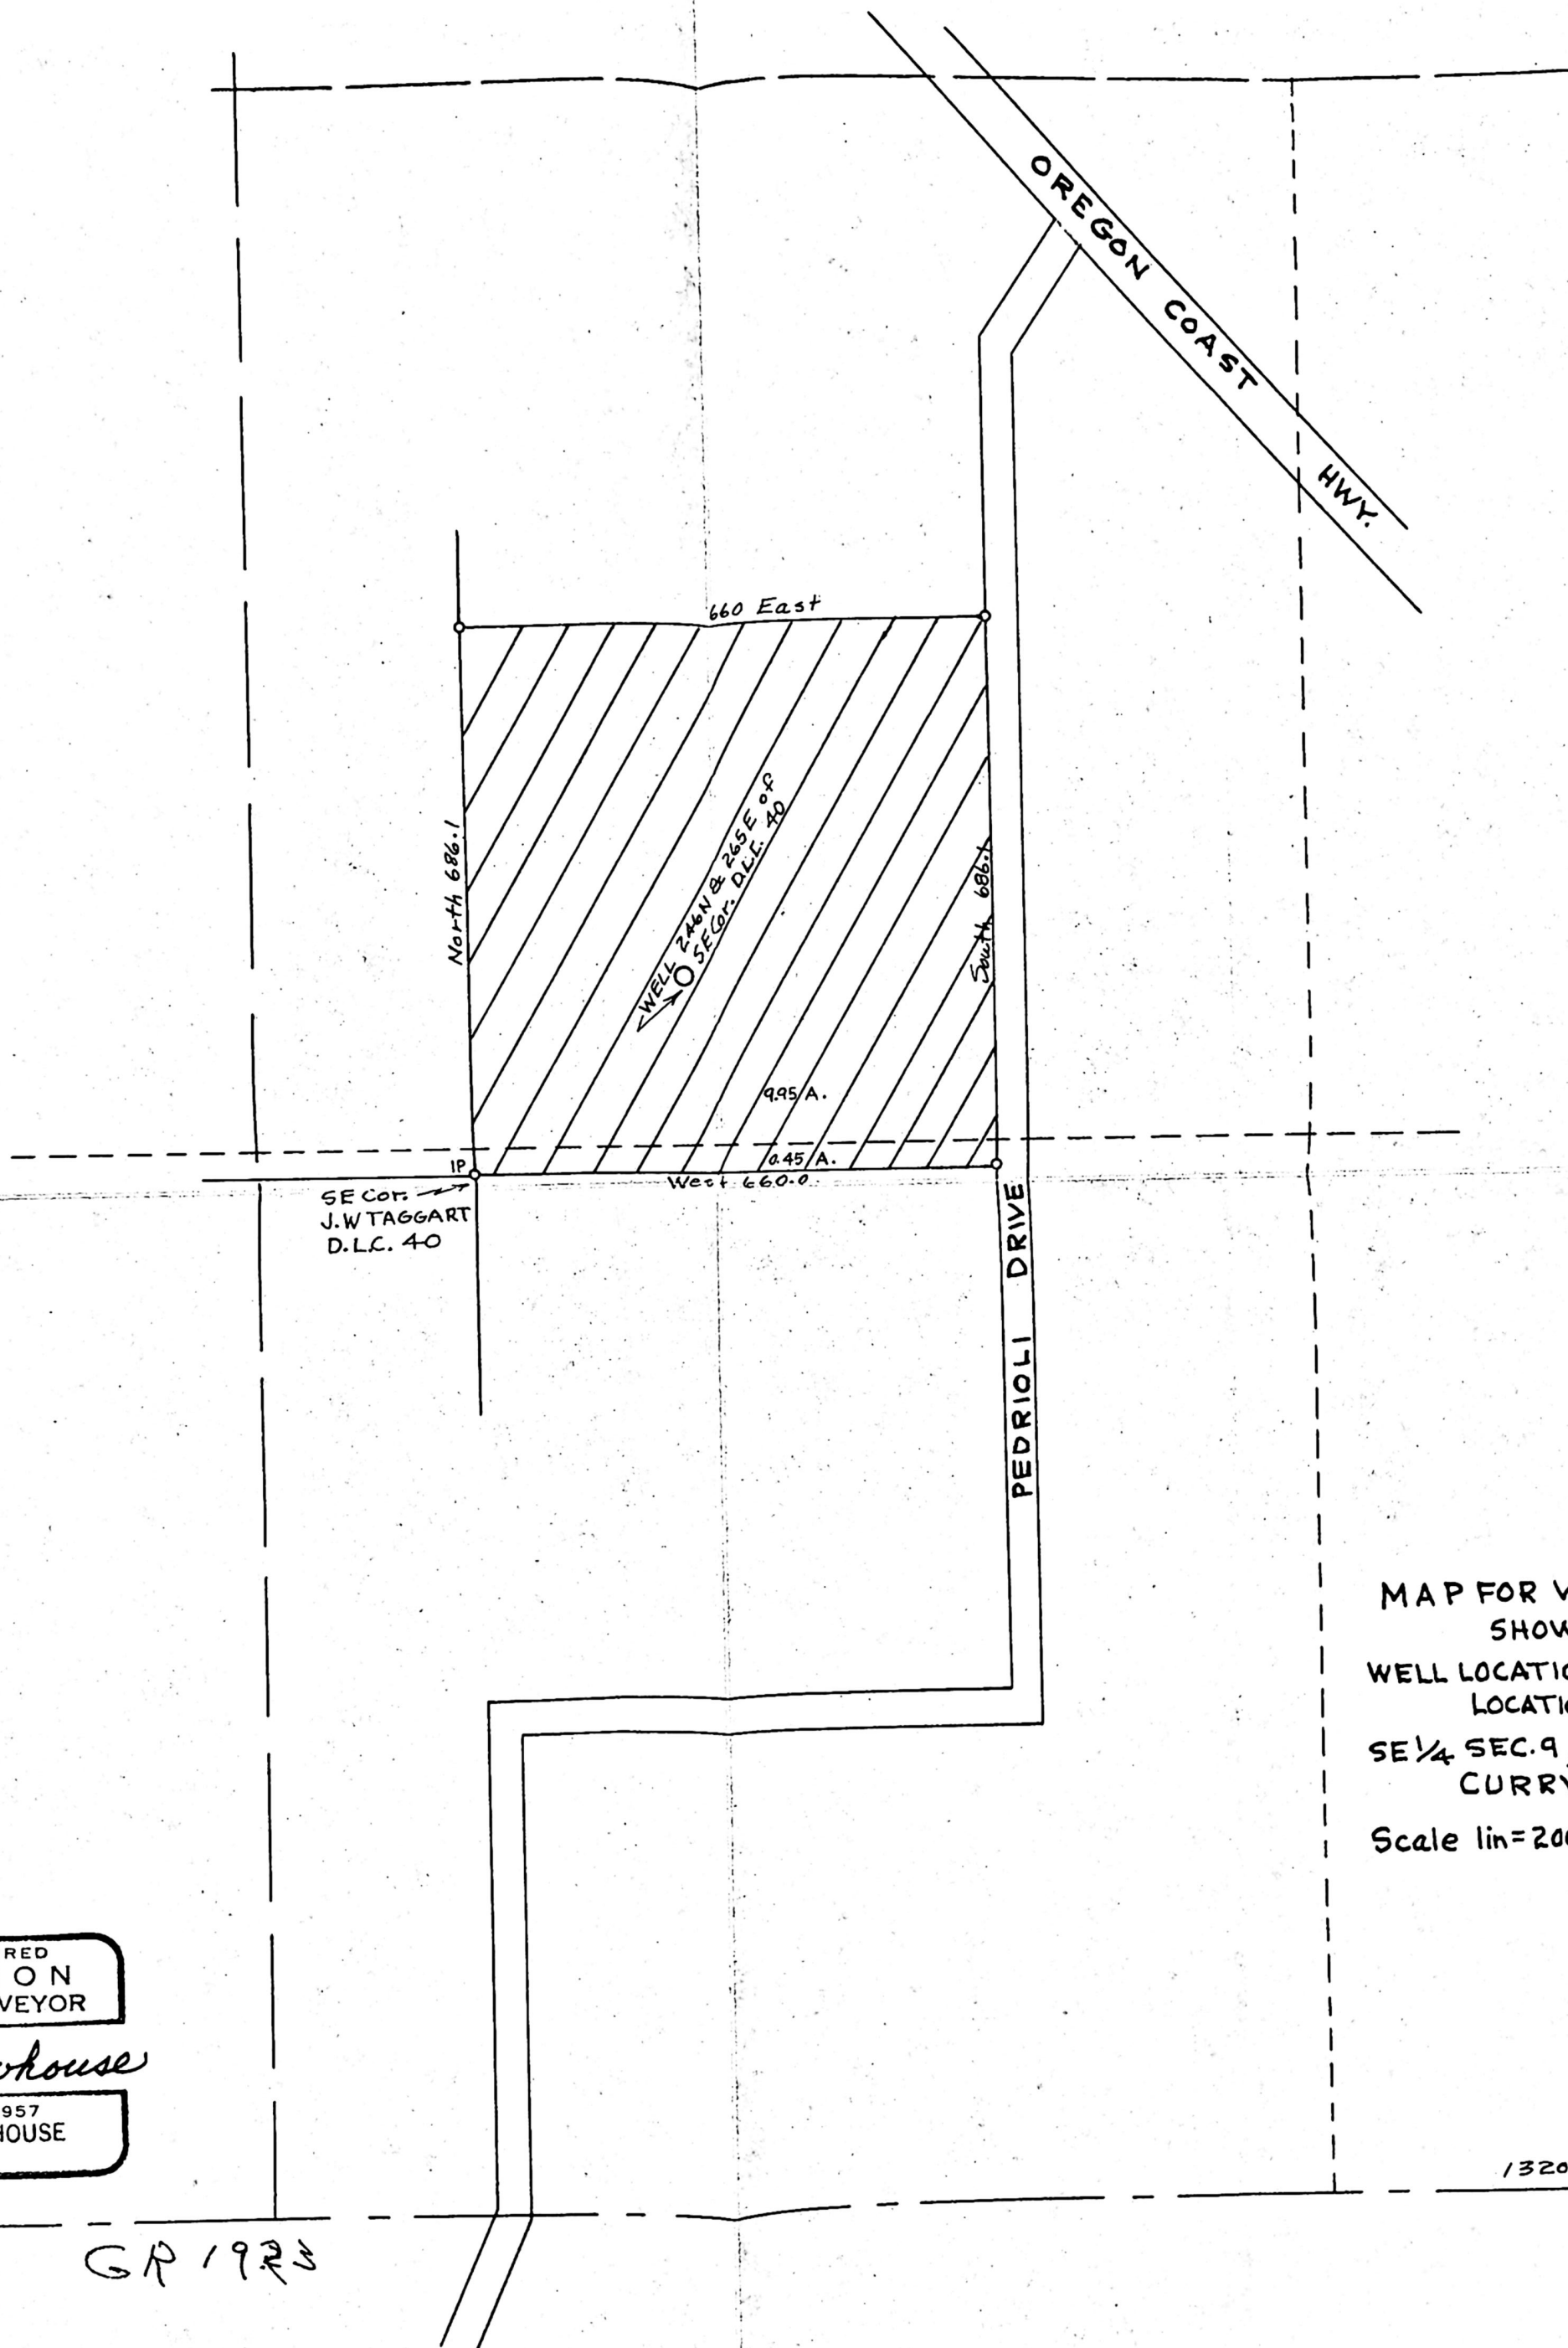

MAP FOR V.E. ANDERSON
SHOWING
WELL LOCATION & PROPERTY
LOCATION IN
SE 1/4 SEC. 9, T. 41S., R. 13W., WM
CURRY CO., ORE.
Scale 1 in = 200 ft. June 1958

REGISTERED
OREGON
LAND SURVEYOR
H. J. Newhouse
MAY 10, 1957
H. J. NEWHOUSE
402

GP 1923

1320

9
16