


T-4517



T 41 S R 13 W W.M.

1" = 660'

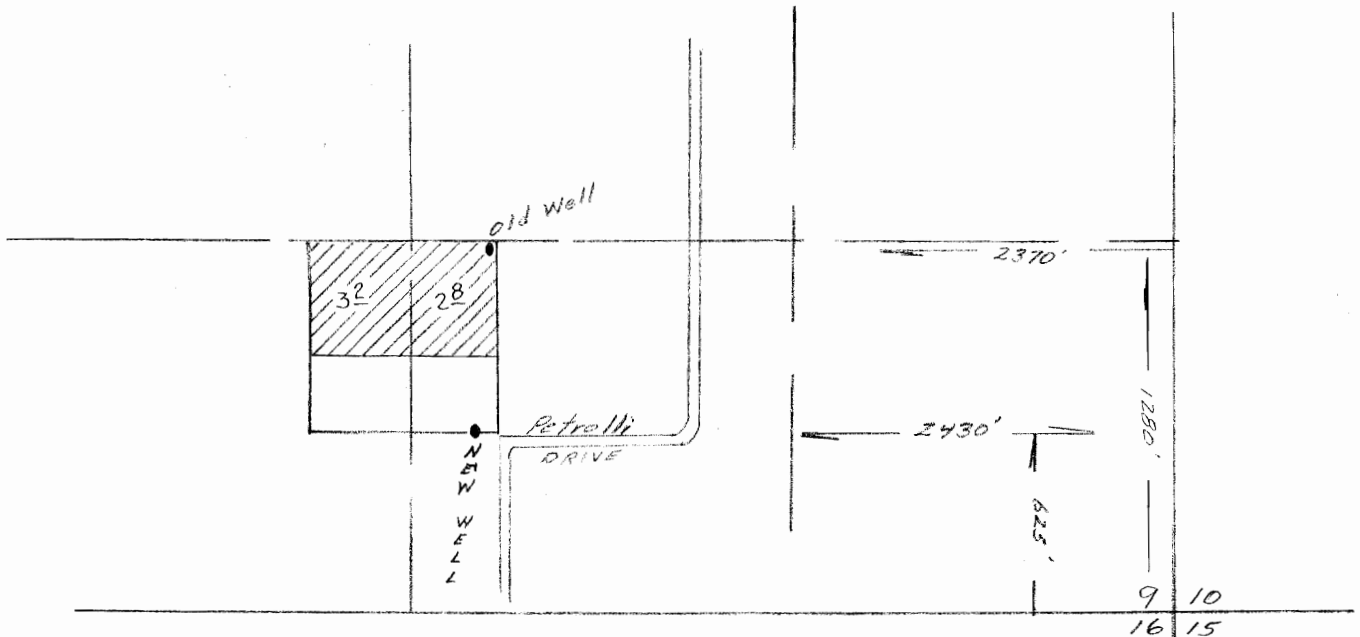

RECEIVED  
MAY 22 1990  
WATER RESOURCES DEPT  
