


T. 7S., R. 38E., W.M.

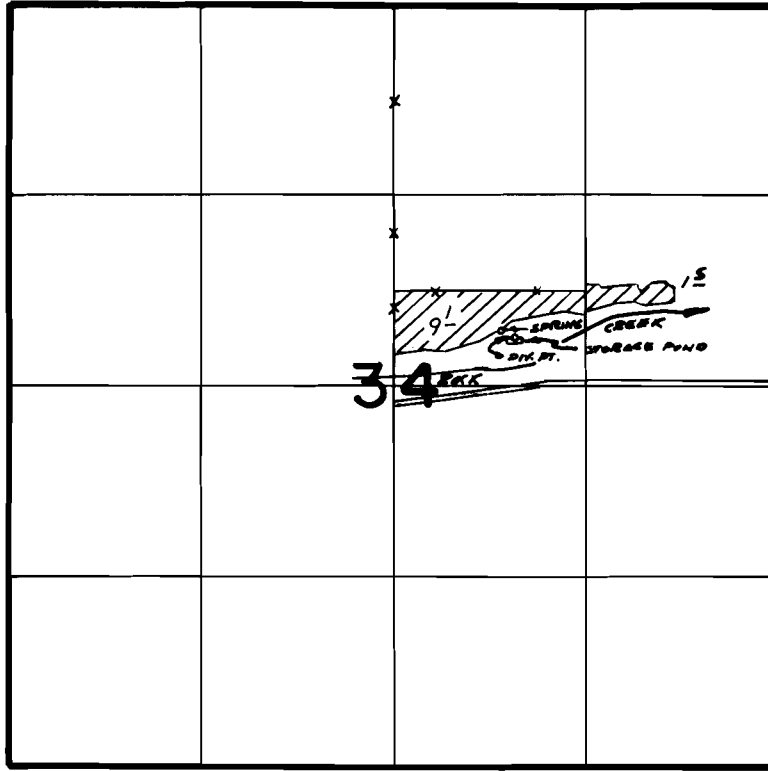

SPRING Loc: 1040' N. & 780' E. FROM C 1/4 COR SEC. 34

**FINAL PROOF SURVEY**  
UNDER

**RECEIVED**

JUN 24 1962

WATER RESOURCES DEPT  
SALEM, OREGON

Application No. 53041. Permit No. 40029...  
IN NAME OF

.....**WILLARD W. DERRICK**.....

Surveyed ...12.7.6... 19.7.7., by R. **SARWIN**.....