


T.13S. R.7W.W.M.

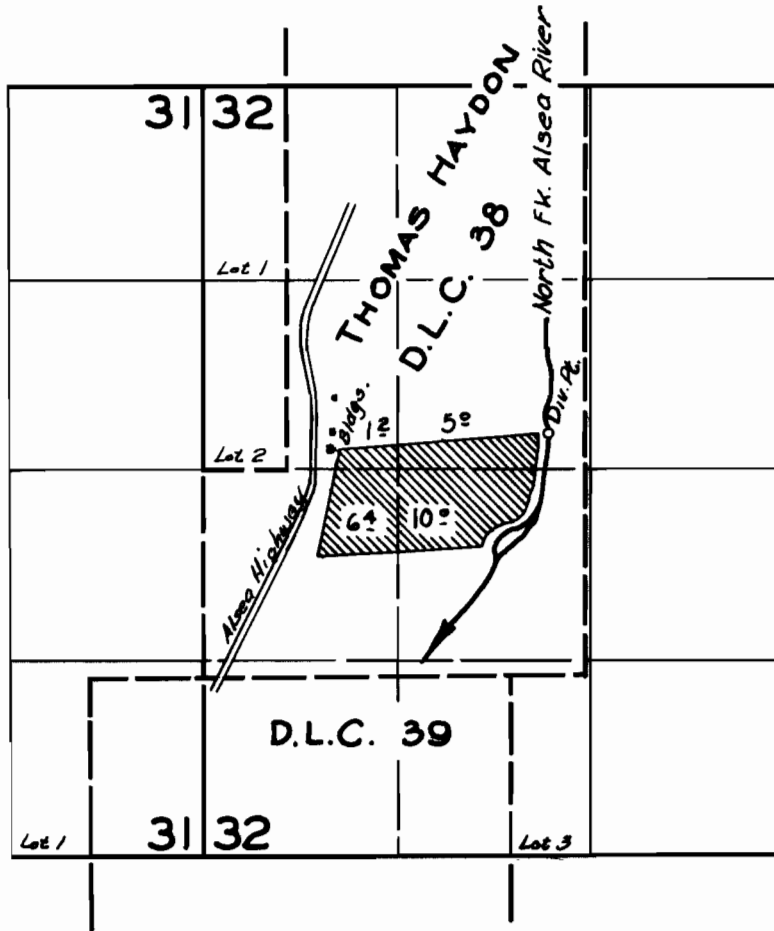

FINAL PROOF SURVEY
UNDER

Application No. 27,934 Permit No. 21999.
IN NAME OF

CECIL M. HAYDEN

Surveyed 1 Oct. 1958, by C. O. Bartels