


# T.13S.R.7W.W.M.

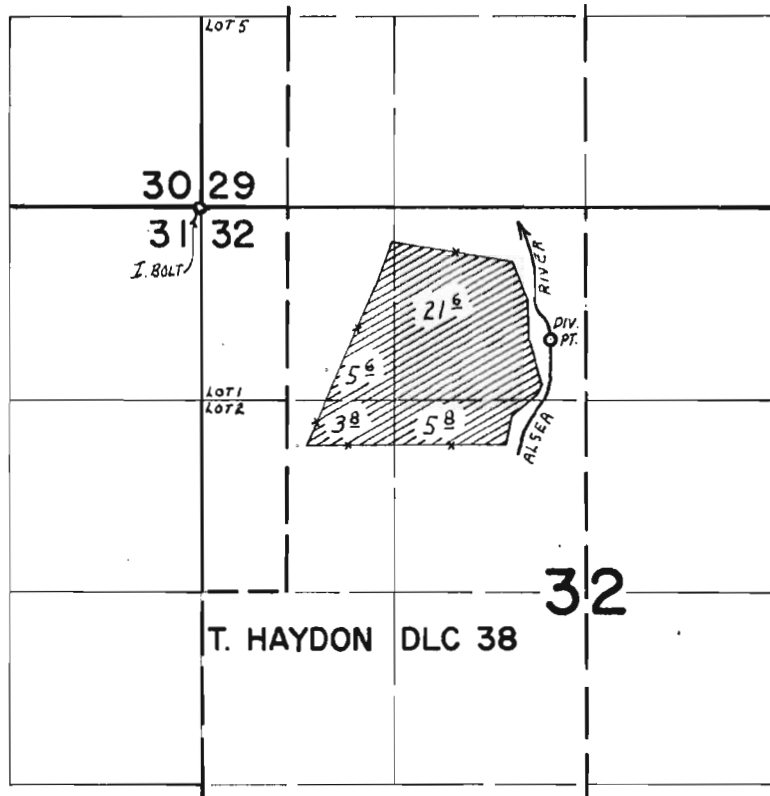

DIV. PT. LOC. 910' S. & 2910' E. FROM NW COR. SEC. 32

## FINAL PROOF SURVEY

UNDER

Application No. 42421 Permit No. 31743

IN NAME OF

JACK TAYLOR

Surveyed JULY 31 19 70, by L. E. GOULD