


T. 28 S., R 6 W., W.M.

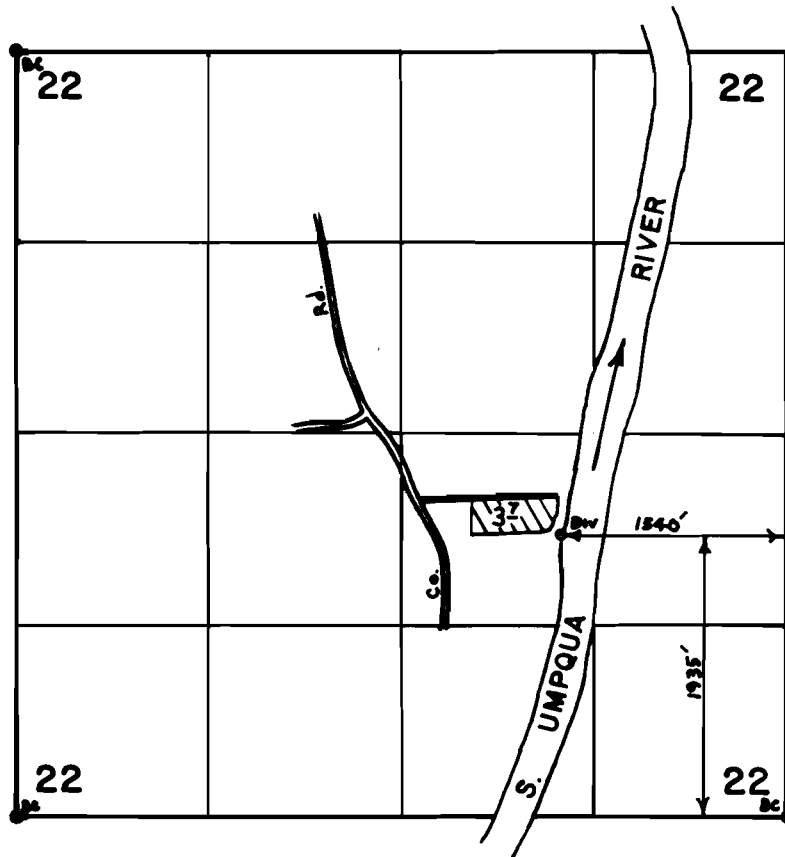

**FINAL PROOF SURVEY**  
UNDER

Application No. 54335 Permit No. 40795  
IN NAME OF

ARCHIE AMORDE

Surveyed SEPT. 28 1977, by D.W. SPARKS