


T.27S., R.6W.W.M.

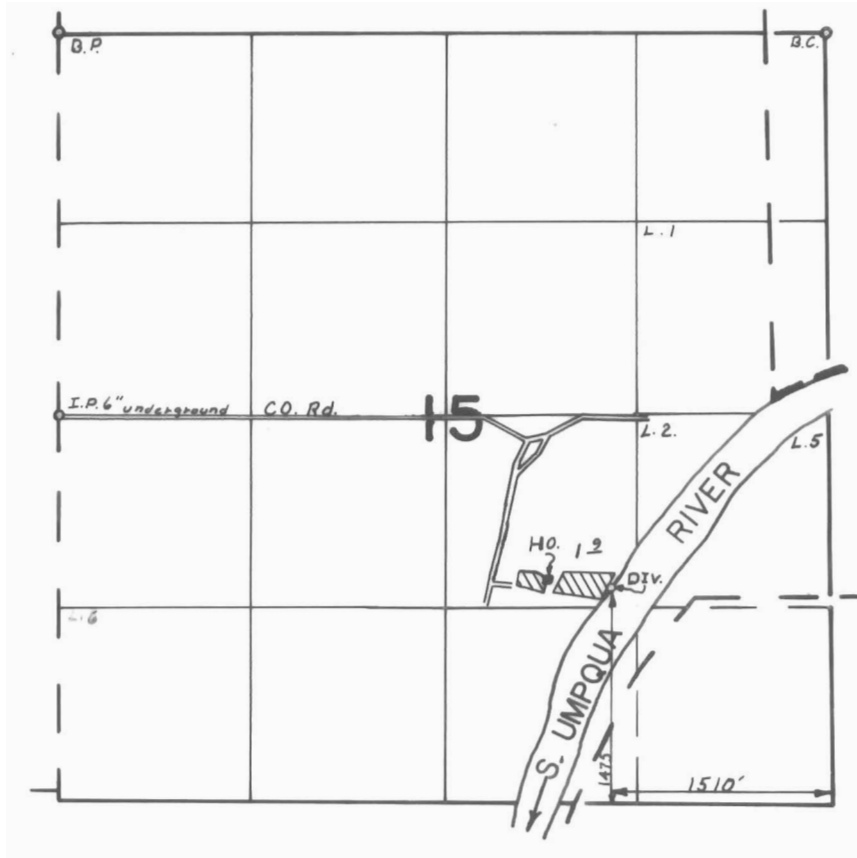

FINAL PROOF SURVEY
UNDER

Application No. 49582 Permit No. 37208
IN NAME OF

TERRY & DONA BERGSTROM

Surveyed OCT 17 1977, by D.W. SPARKS