


T. 25S. R. 7¹/₂ W W. M

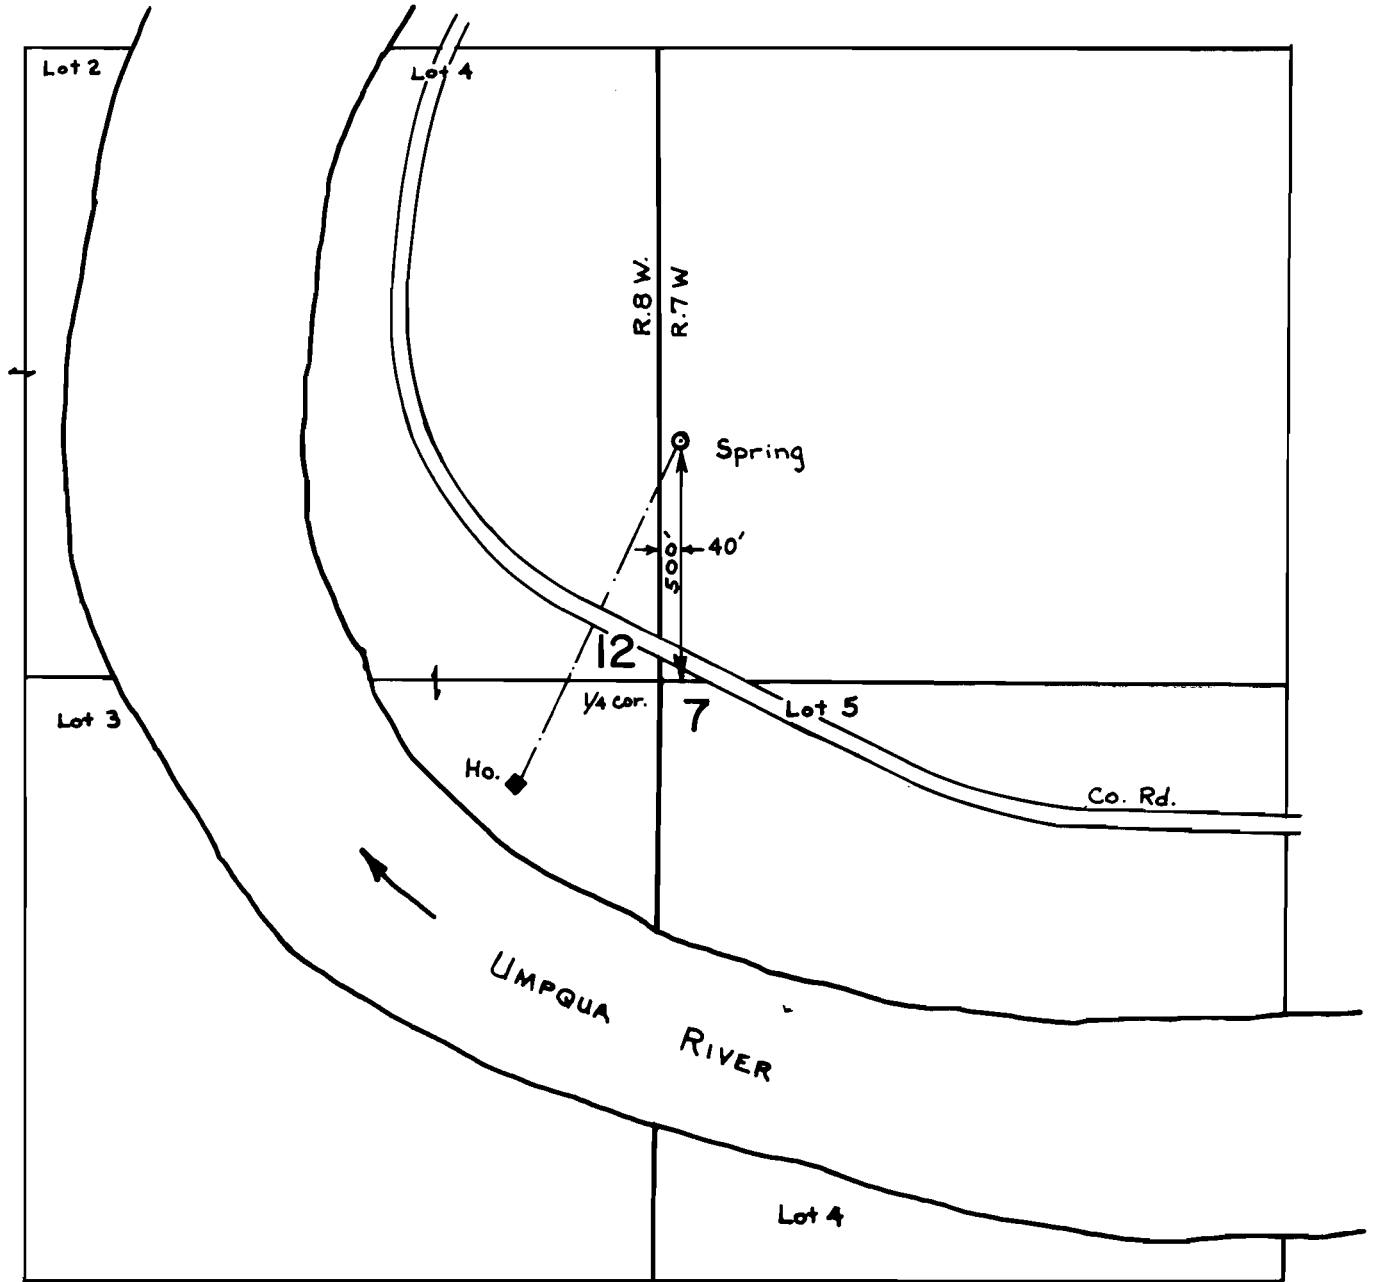

SCALE: 1" = 400'

FINAL PROOF SURVEY
UNDER

Application No. 50634 Permit No. 37318
IN NAME OF

GRAYCE BARTER HATCHER

Surveyed Sept. 18, 1978, by D. Henry