


T.28S. R.6W. W.M.

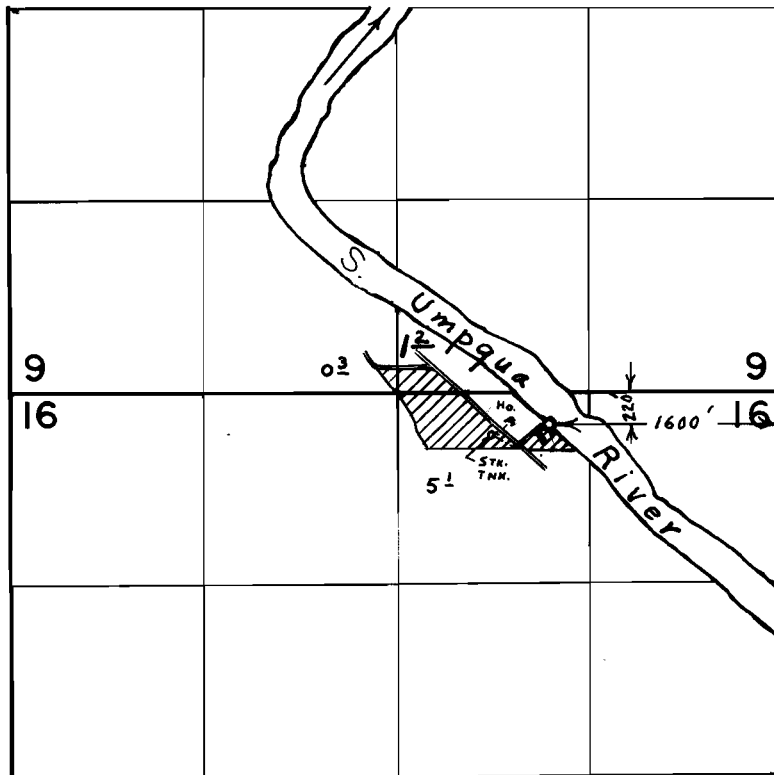

FINAL PROOF SURVEY
UNDER

56142 42557
Application No. 50349 Permit No. 38009
IN NAME OF

ARNOLD MORTON

Surveyed July 27, 1976, by L. E. Gould
Aug. 3, 1978, D. W. Sparks