


T.26 $\frac{1}{2}$ 27S. R.6W. W.M.

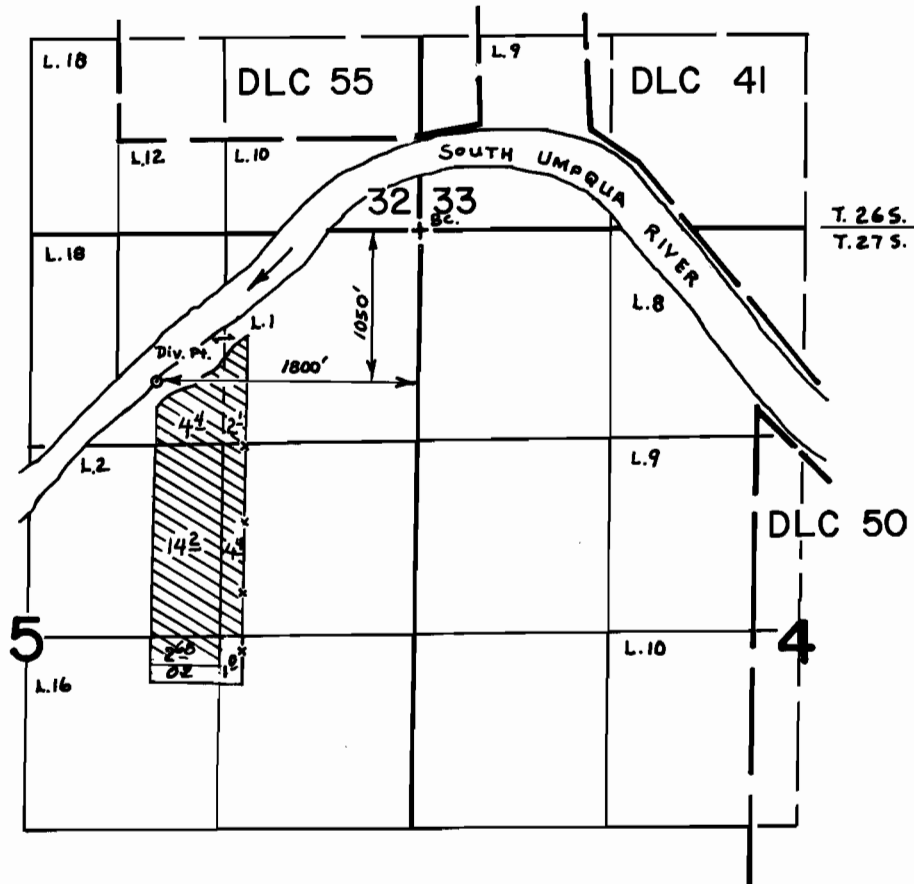

SCALE: 4" = 1mi.

FINAL PROOF SURVEY
UNDER

Application No. 55480.. Permit No. 42063..
IN NAME OF

.....STEPHAN BLAKE CONN.....

Surveyed Dec. 8.... 1977., by D.W. Sparks...