



T.13 & 14S. R. 31 & 32E. W.M.

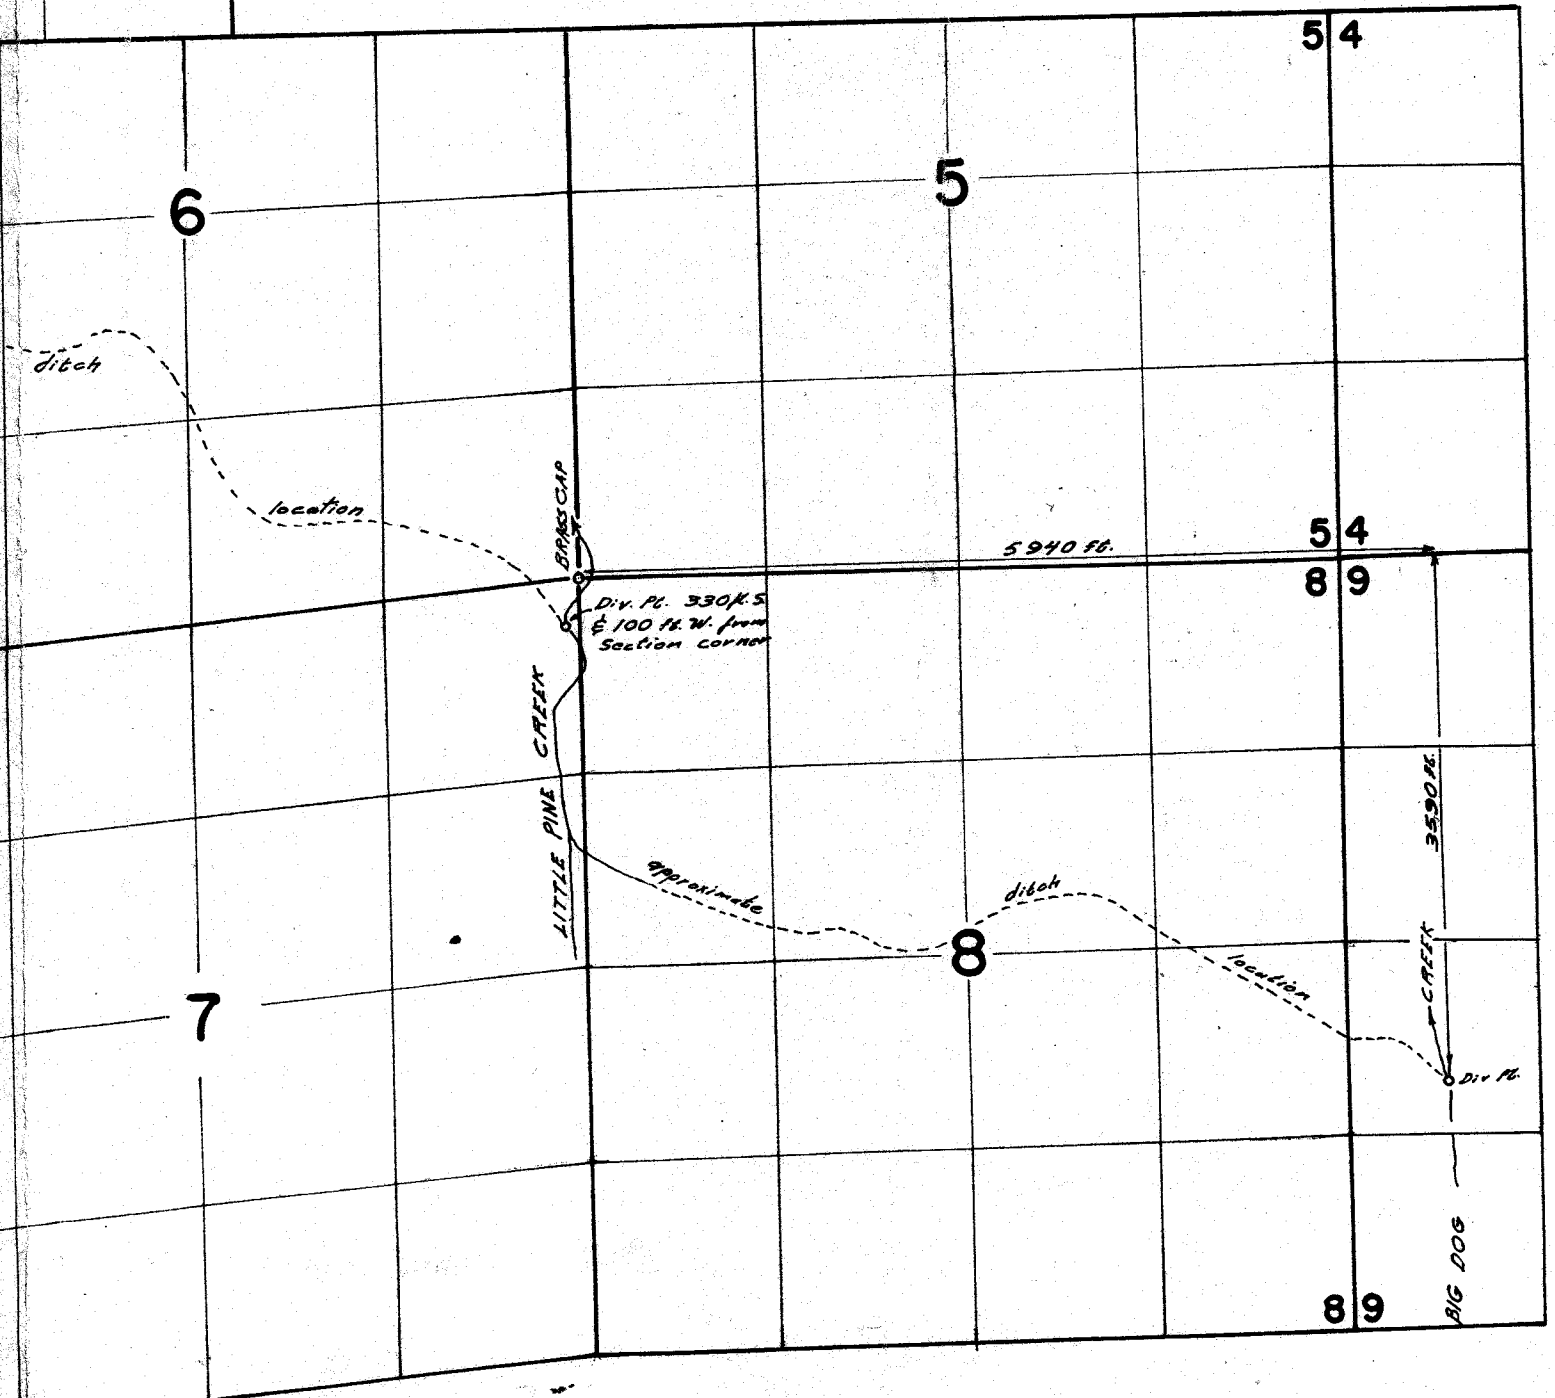

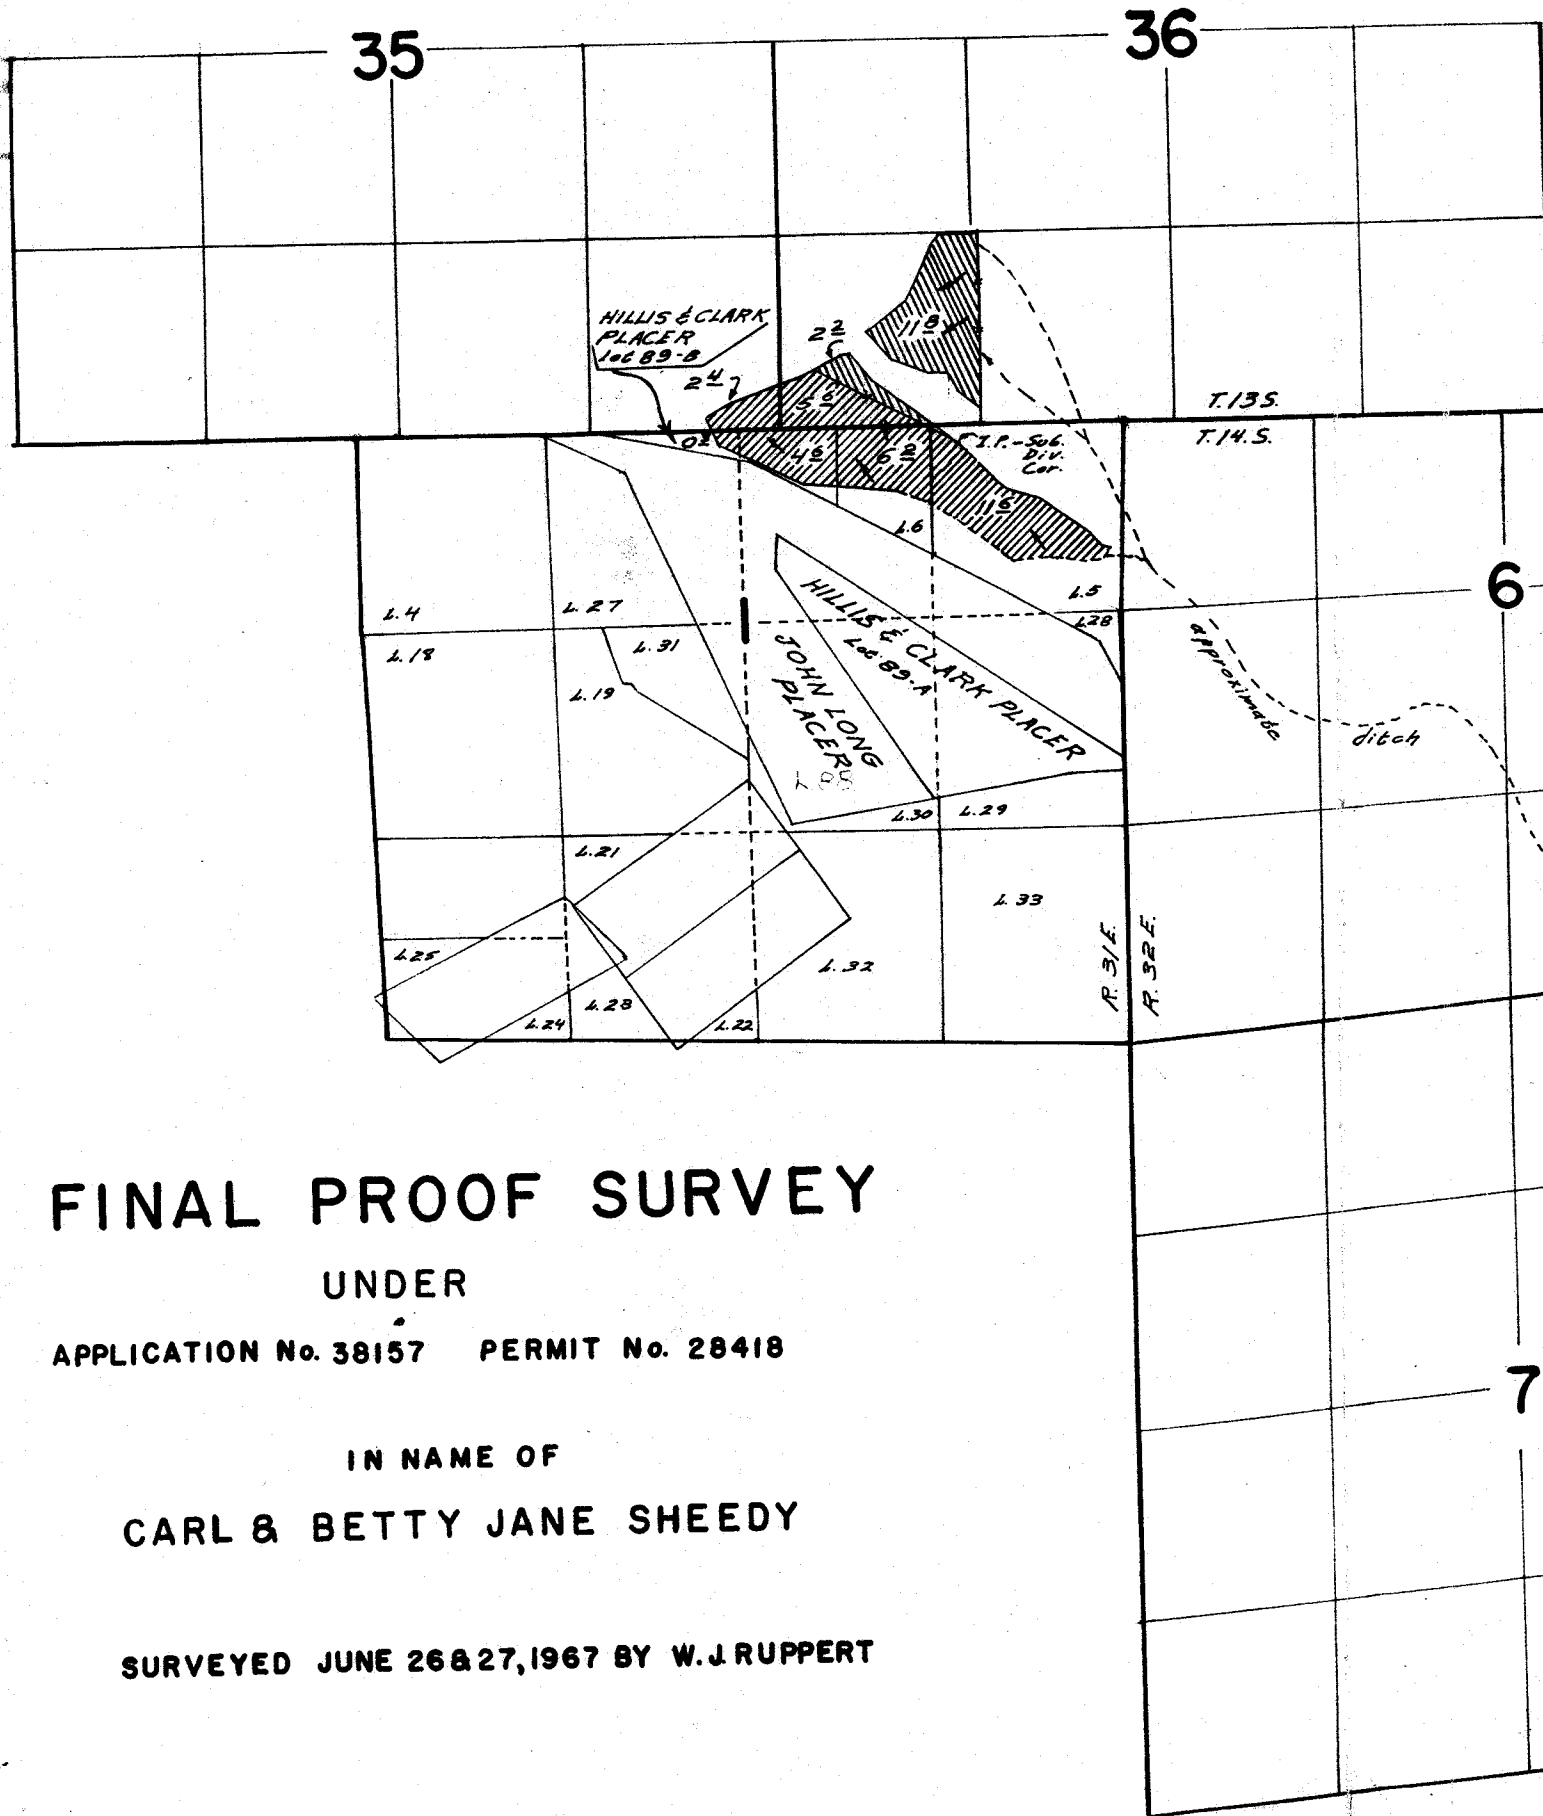

FINAL PROOF SURVEY

UNDER

APPLICATION No. 38157 PERMIT No. 28418

IN NAME OF

CARL & BETTY JANE SHEEDY

SURVEYED JUNE 26 & 27, 1967 BY W. J. RUPPERT