


T.36S.R.32 $\frac{3}{4}$ E.W.M.

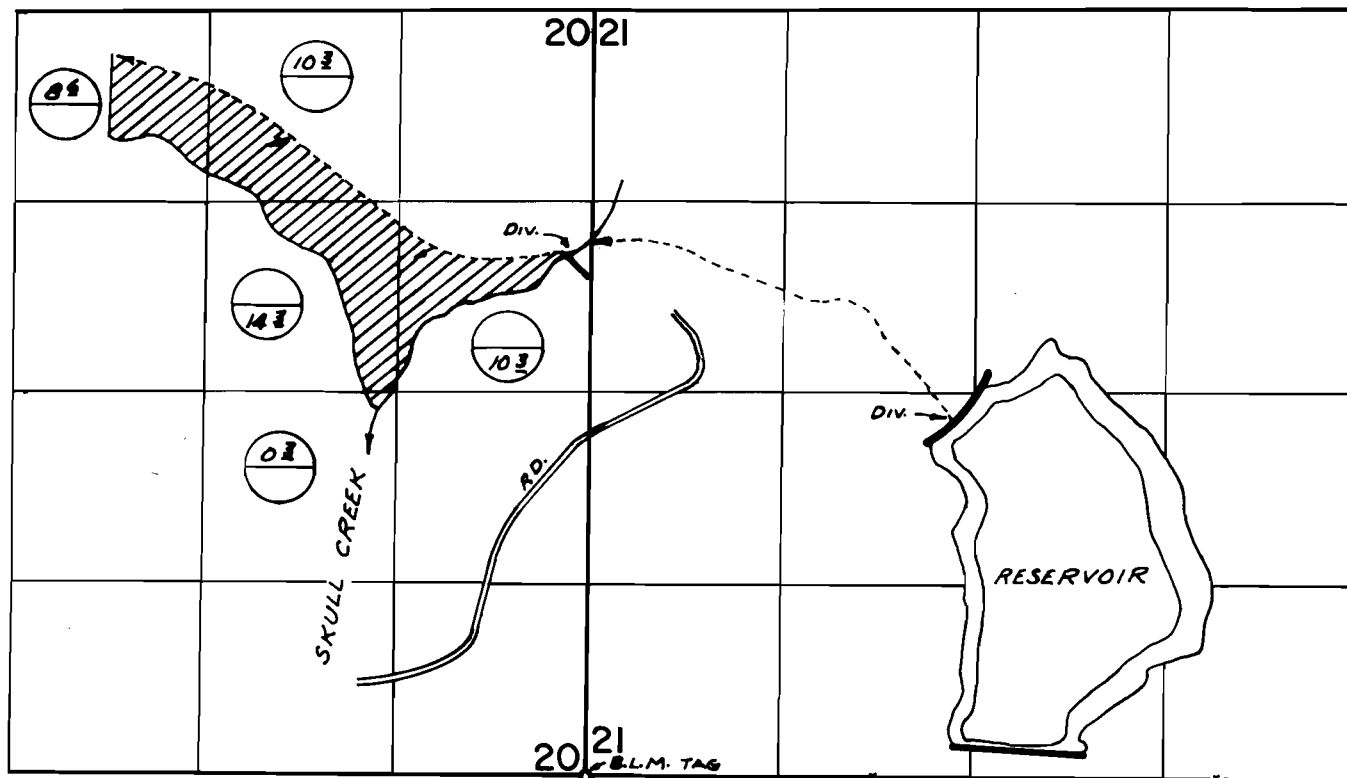

DIV. PTS. LOC: CREEK - 3580' N. & 150' W.,
RES. - 2450' N. & 2500' E., BOTH FROM S.E. COR. SEC. 20

○ PRIMARY
○ SUPPLEMENTAL

FINAL PROOF SURVEY UNDER

Application No. 44100 Permit No. 32944
IN NAME OF

MR. ROBERTO FLORIANI

Surveyed JUNE 22, 1976, by R. MUCKEN