


T.38&39S., R.2W., W.M.

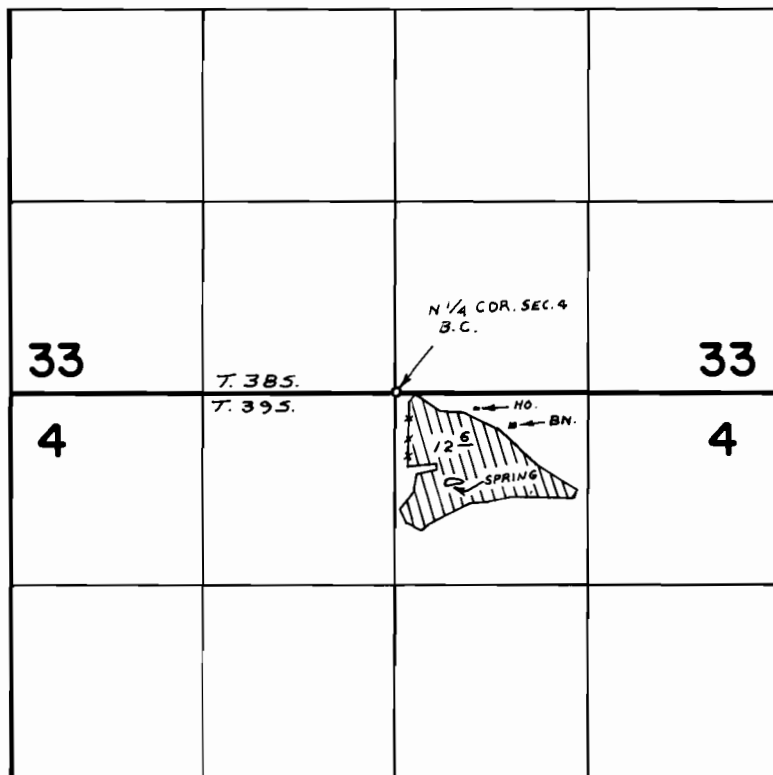

SPRING LOC. : 610' S. & 410' E. FROM N 1/4 COR. SEC. 4

FINAL PROOF SURVEY UNDER

Application No. 42558 Permit No. 31806
IN NAME OF

KENNETH R. &/OR SHEILA FERSON JENKINS

Surveyed OCT. 26 1978 by B. SUND