


5
49781

T.9S. R.15E. W.M.

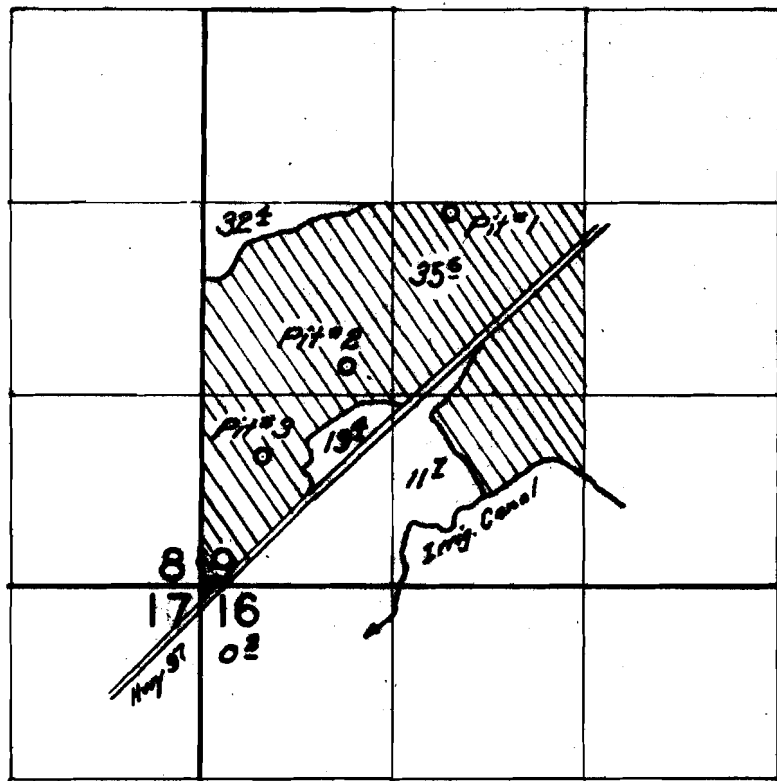

FINAL PROOF SURVEY UNDER

Application No. *G-1585*. Permit No. *G-1456*
IN NAME OF

Lee Vern Bothwell

Surveyed *Oct. 20*, 1962, by *Carl R. Baker*

G-1456
1962-0
DDU-611-135