


T.35 S., R. 6 W., W.M.

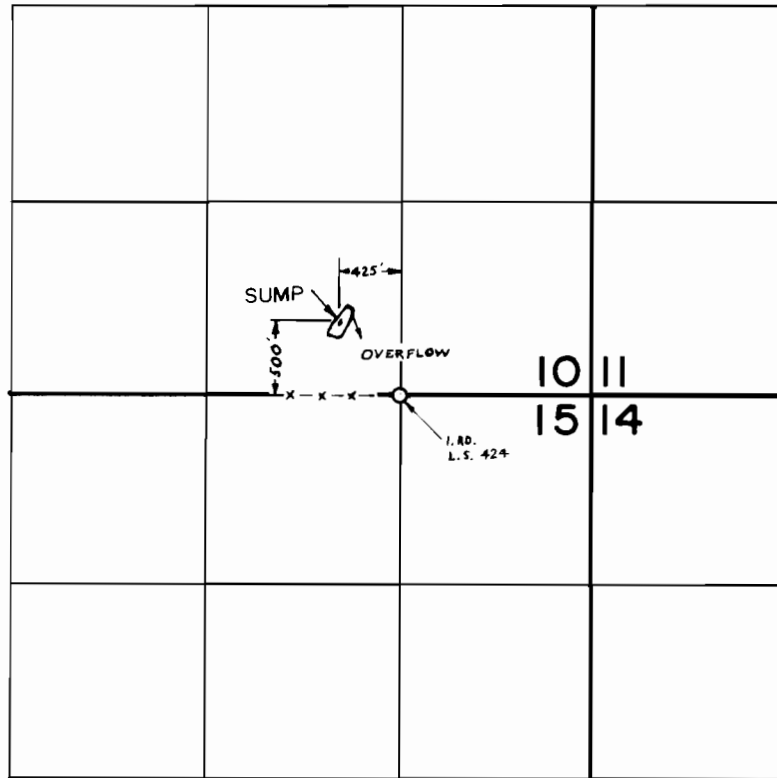

FINAL PROOF SURVEY
UNDER

Application No. G-6229 Permit No. G-6087
IN NAME OF

EDWIN L. ERNIE

Surveyed NOV. 2. 1977. by B. SUND