


This well location  
is erroneous. Correct  
location is on F.P. MAP **S. R. 4 & 5 W., W.M.**  
for T-5434.

PER SLCB

mmw  
1/12/85

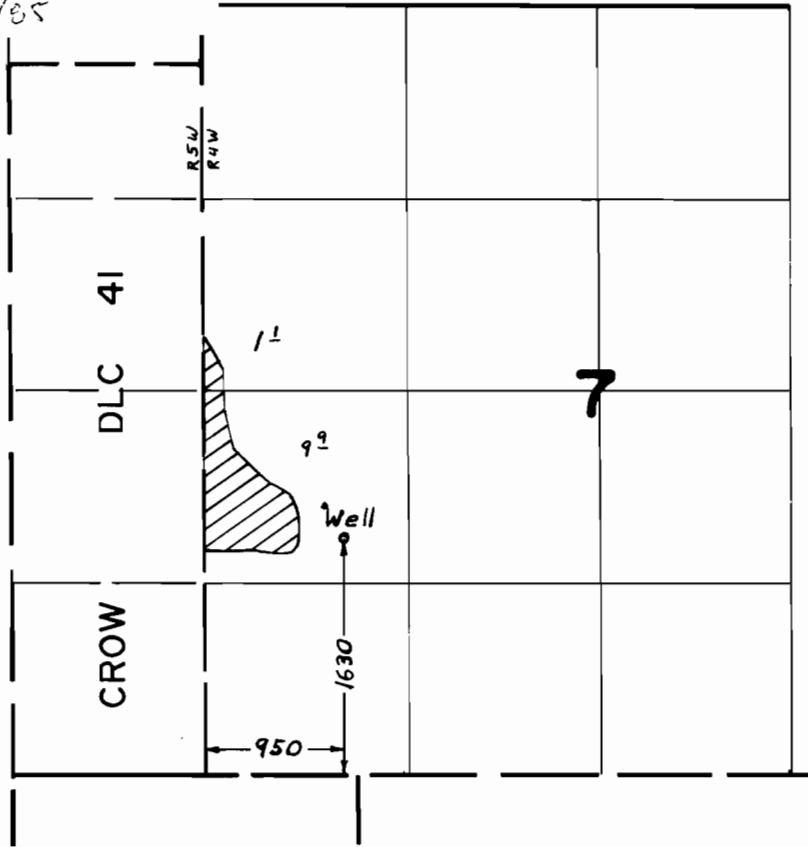

**FINAL PROOF SURVEY**  
UNDER

Application No. G-7836. Permit No. G-7214...  
IN NAME OF

.....RAYMOND JAGER.....

Surveyed MAY...24 1978., by J.S. DONALDSON