


I.P.

14

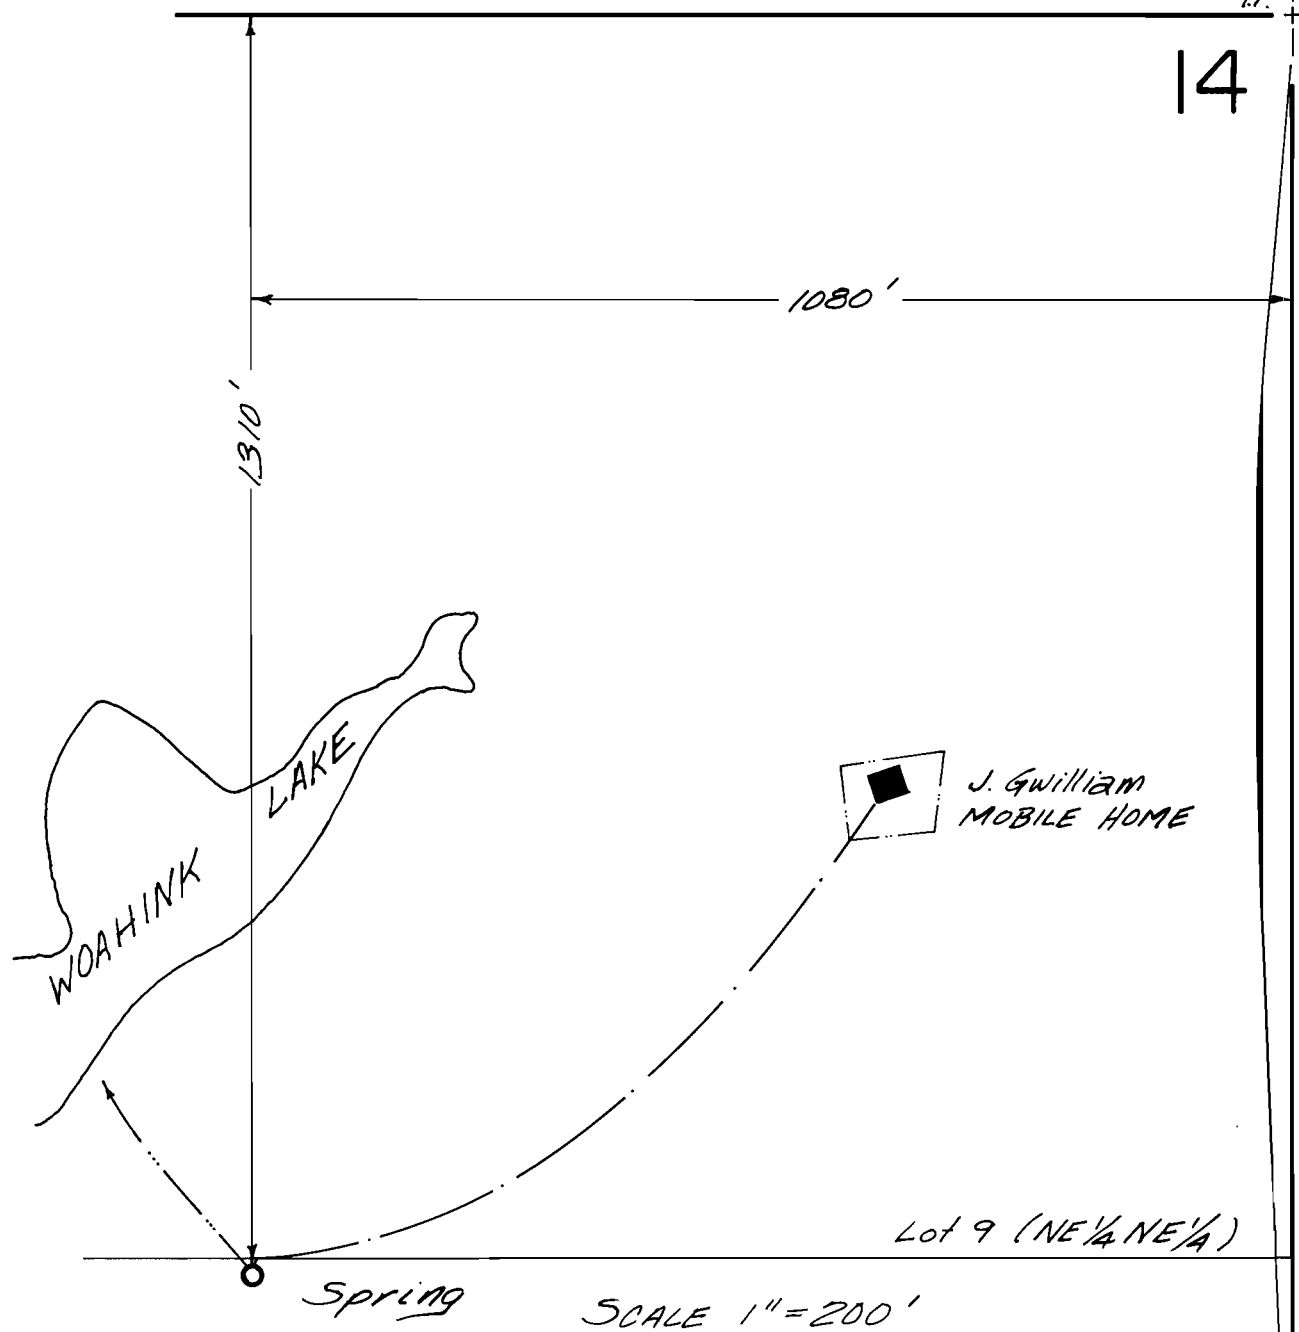

FINAL PROOF SURVEY
 UNDER

Application No. 53264 Permit No. 39513

IN NAME OF

James R. Gwilliam

Surveyed JAN. 7, 1981, by A. Brown