T.10S. R.3&4W., W.M.

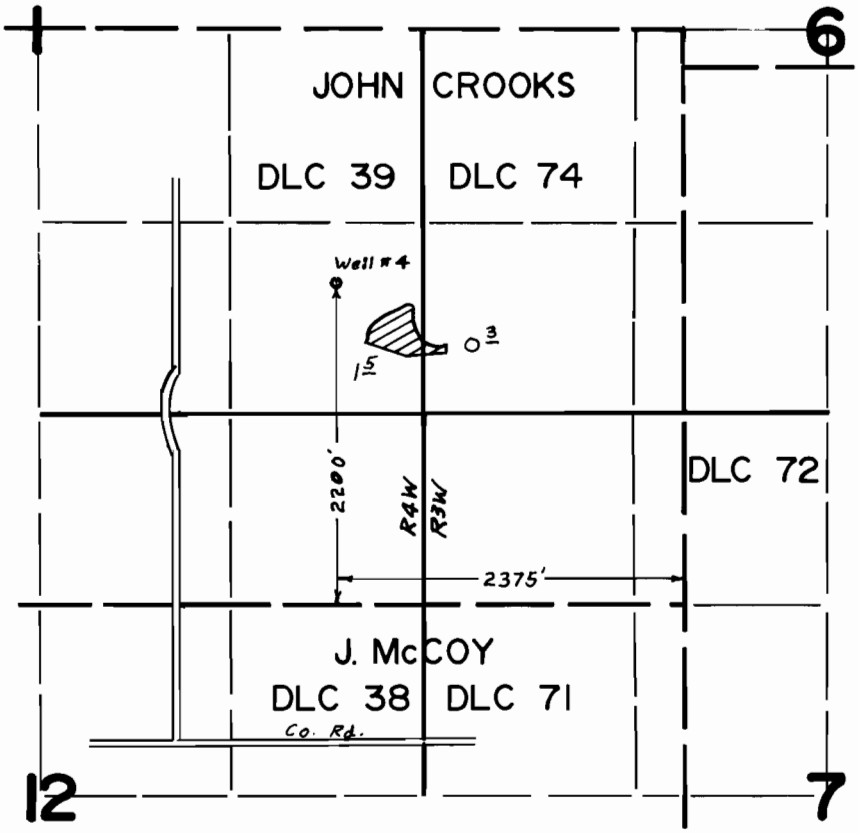

FINAL PROOF SURVEY
UNDER

Application No. G-7816 Permit No. G-7227
IN NAME OF

ELMER L. COOK

Surveyed APR 19 1978, by S.P. APPLEGATE

APP'L - G-220 F.P. & DFM-LL - 158