


Township 12 South Range 15 East

6-2
5-2
4-2

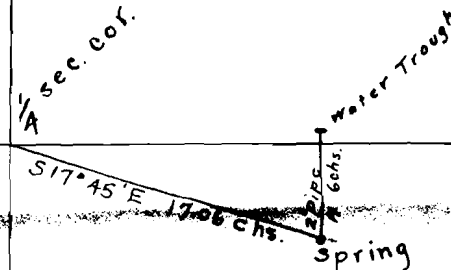

1307

STATE ENGINEER
RECEIVED
MAY 26 1920
SALEM - OREGON

Section 9

I, Raymond G. Heider, of Madras Oregon do hereby certify that this map was made from notes taken during an actual survey made by me on May 2 1920, and that it correctly represents the works described in the accompanying application, together with the location of stream and other ditches in the immediate vicinity

Raymond G. Heider

7307