


T.12S. R.2W., W.M.

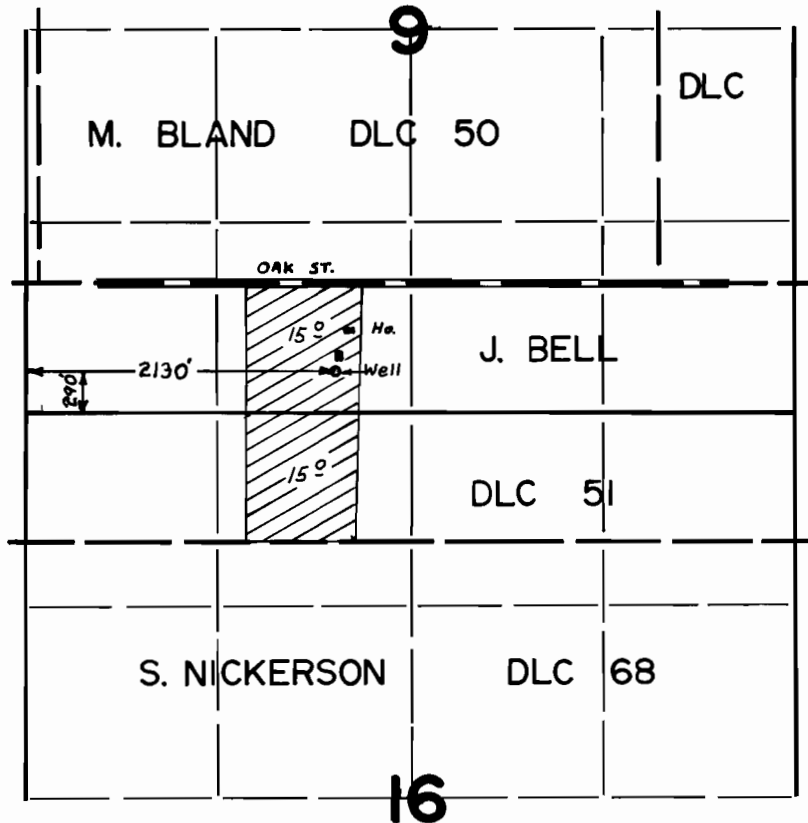

FINAL PROOF SURVEY UNDER

Application No. G-7564. Permit No. G-7030...
IN NAME OF

CHARLES A. SHOWN

Surveyed APR 17 1978, by S.P. APPLEGATE