


T.12S. R.2W., W.M.

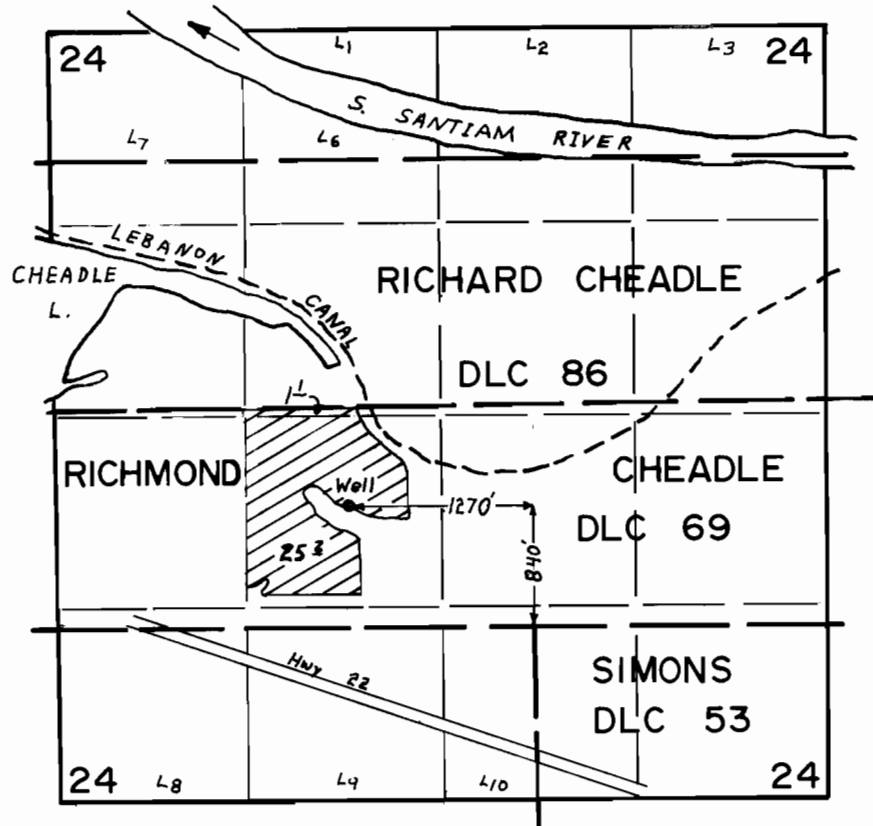

FINAL PROOF SURVEY UNDER

Application No. G-7949. Permit No. G-7730.
IN NAME OF

.....
Surveyed APR. 17. 1978, by S. P. APPLIGATE