


T.13S. R.3W., W.M.

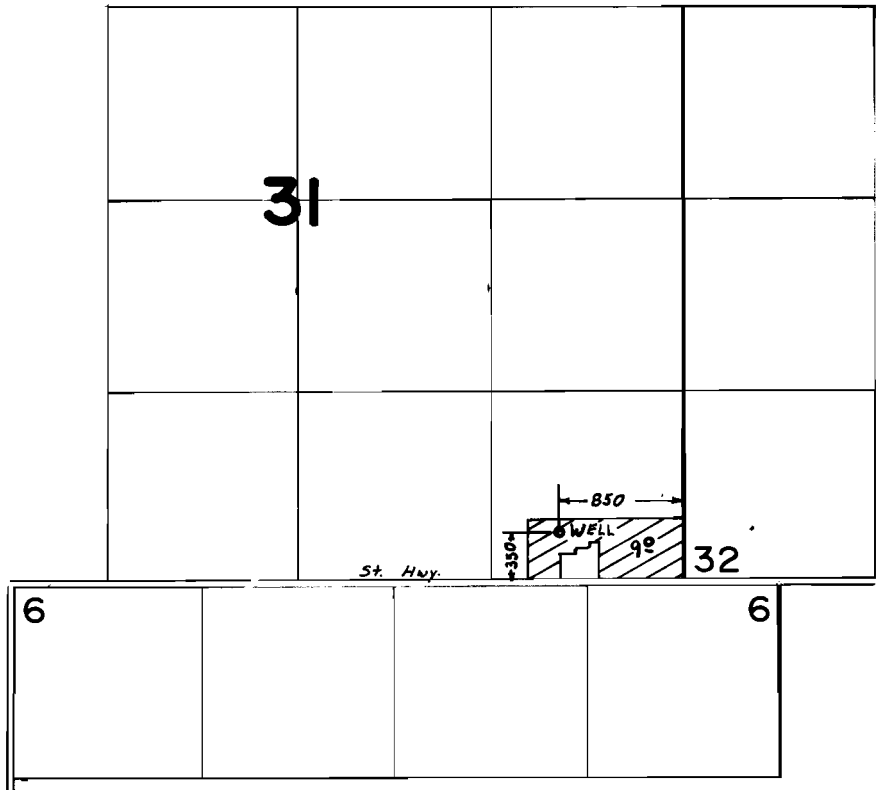

FINAL PROOF SURVEY UNDER

Application No. G-7039... Permit No. G-6526...
IN NAME OF

.....DEL. WILLIAMSON.....

Surveyed APR. 18... 1978., by S.P. APPLEGATE