


T.10S. R.1&2 W., W.M.

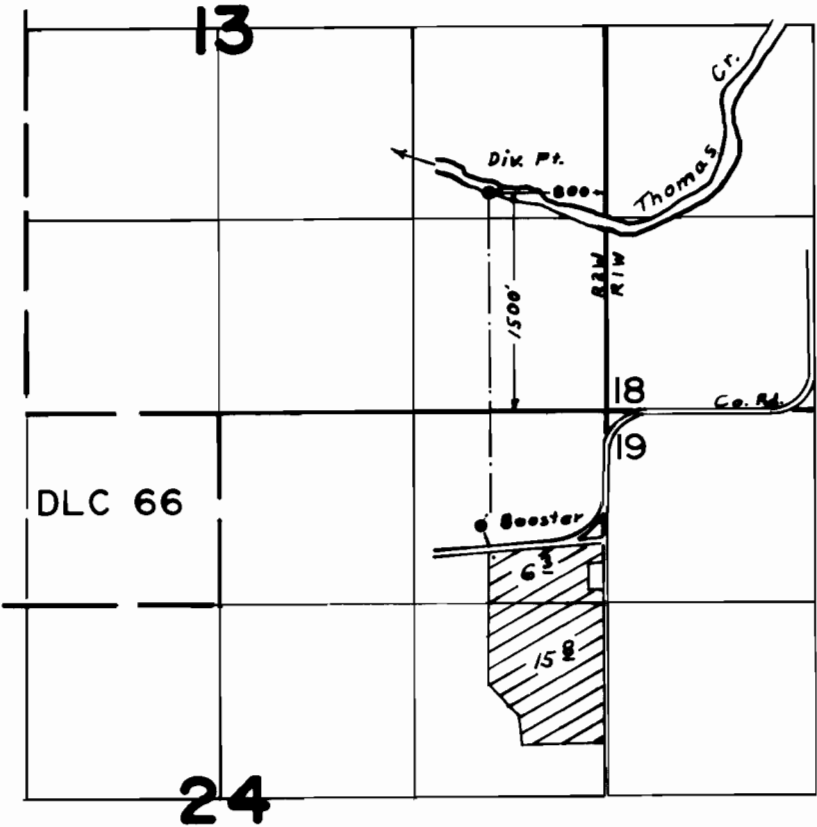

**FINAL PROOF SURVEY**  
UNDER

Application No. 47965... Permit No. 35979  
IN NAME OF

JERRY M. FAULTUS

Surveyed APR. 12. 1978. by S.P. APPLGATE