


T.10&11S., R.1W., W.M.

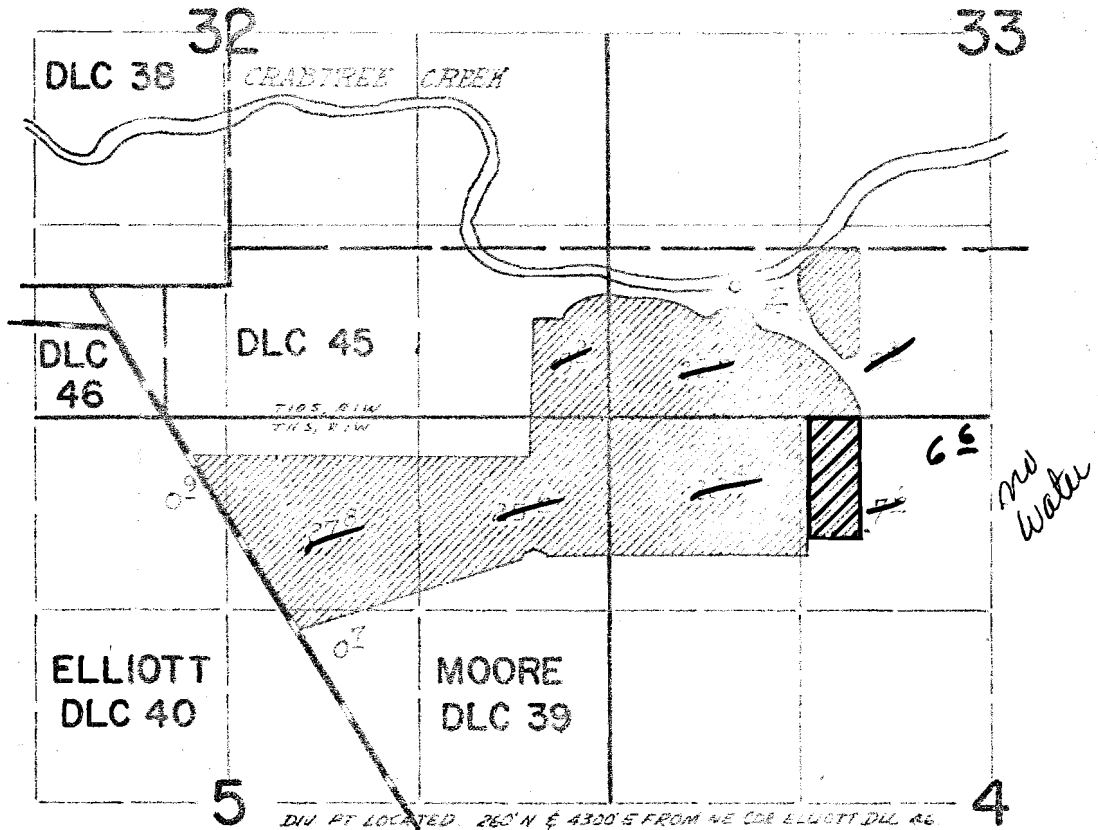

~~FINAL PROOF SURVEY~~
UNDER

RECEIVED

MAY 11 1977

WATER RESOURCES DEPT.
SALEM, OREGON

Application No. ~~44091~~ Permit No. ~~32940~~
IN NAME OF

CHARLES CROSS

Surveyed ~~May 21~~ 1974, by ~~D. Morby~~

Application No. 55880
Permit No. 41915